


T. 19S. . R. 12W. . W. M.

GOV'T LOT 3, SECTION 3

HWY 101

PREPARED BY
STUNTZNER ENG & FOR
PO BOX 118/705 S 4th
COOS BAY, OR.

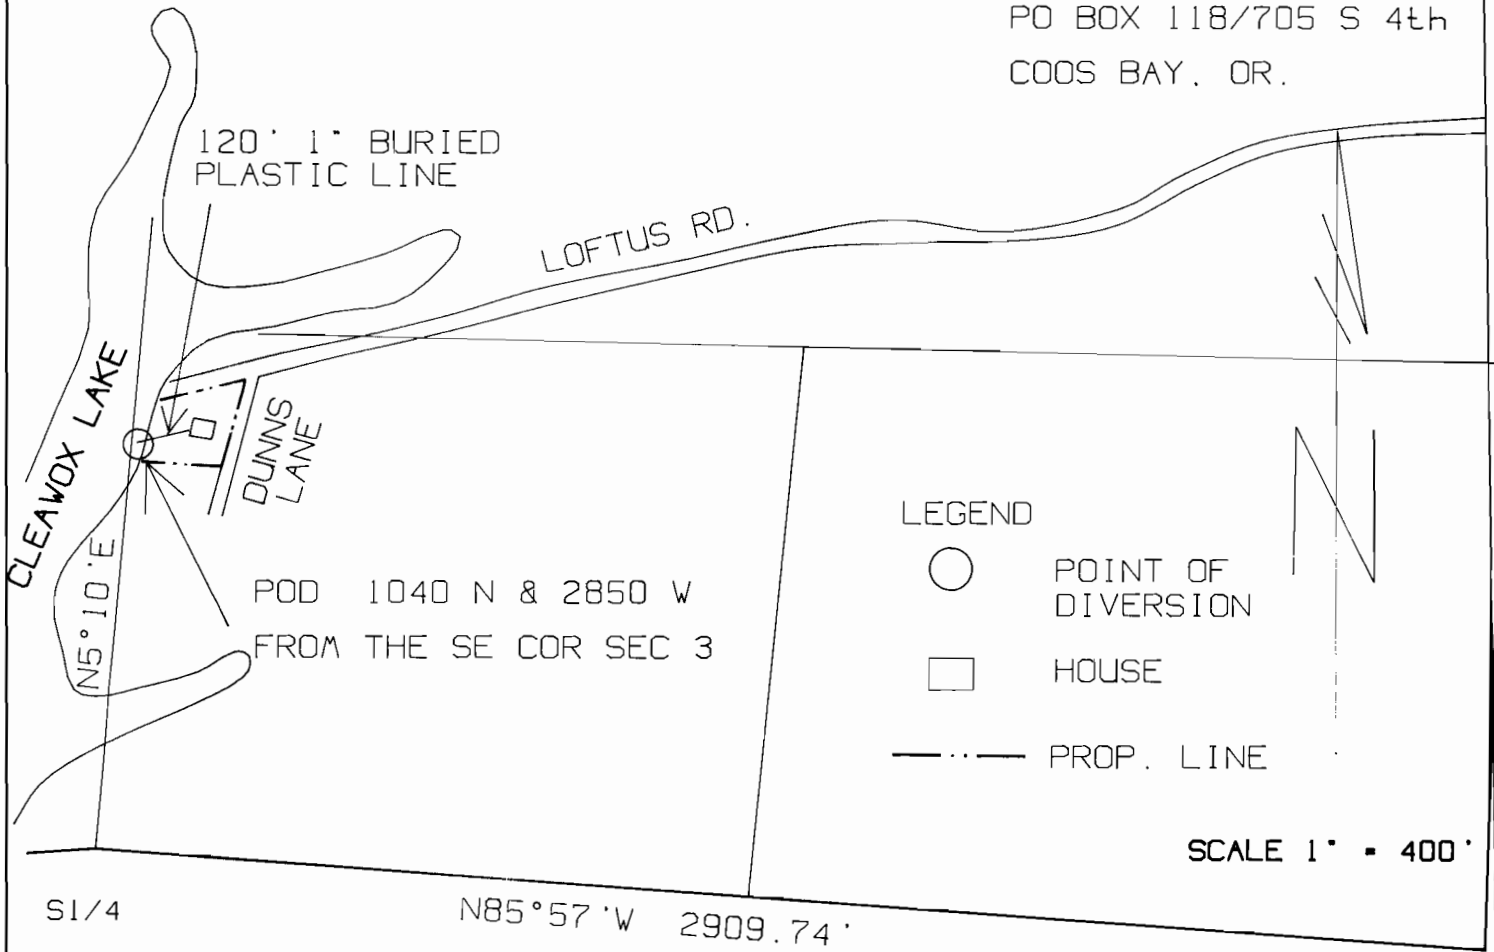

EXAMINERS DISCLAIMER STATEMENT

THE PREPARATION OF THIS MAP WAS FOR THE PURPOSE OF IDENTIFYING THE LOCATION OF THE WATER RIGHT ONLY AND HAS NO INTENT TO PROVIDE DIMENSIONS OR LOCATION OF OWNERSHIP LINES.

SE COR
SEC 3

FINAL PROOF SURVEY

Application No. 69396... Permit No. ...50188...

IN NAME OF

.....ROBERT L... AND CAROL M... BOWEN.....

Surveyed ..JULY 12..... 1991... by H.A. WILCOX

