


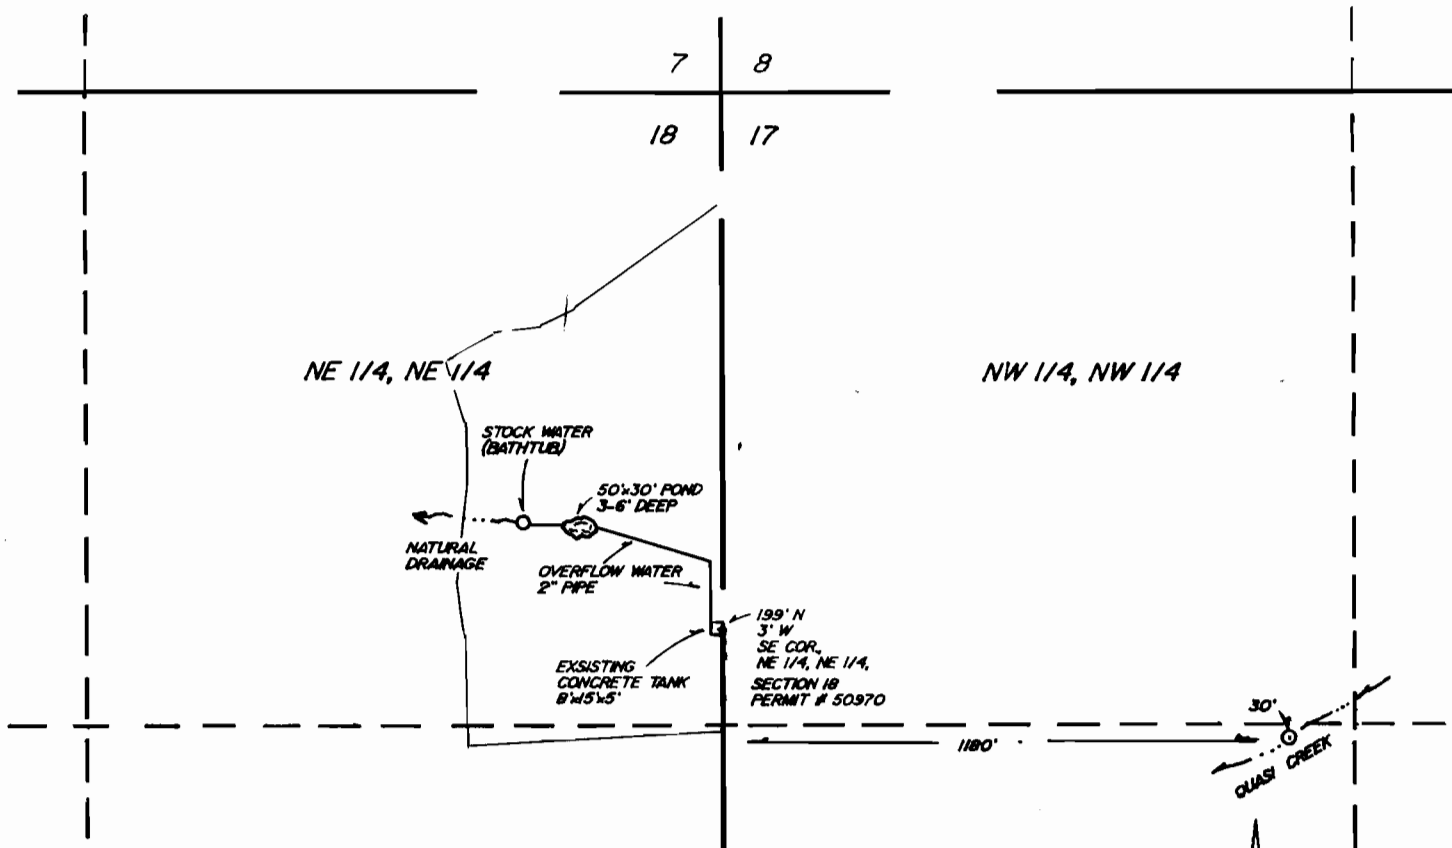

NOTE

The preparation of this map is for the purpose of identifying the location of water right only and has no intent to provide dimensions or location of property ownership lines.

T. 37 S., R. 14 W., W.M.

FINAL PROOF SURVEY

UNDER

Application # 69570 Permit # 50970

IN THE NAME OF

JAMES & TERESA BELL

Surveyed July 8, 1991, by H.J. Newhouse

Scale 1" = 400'

