


T.11 S.R. 9 W.,.W.M.
Section 10
Lincoln County, Oregon

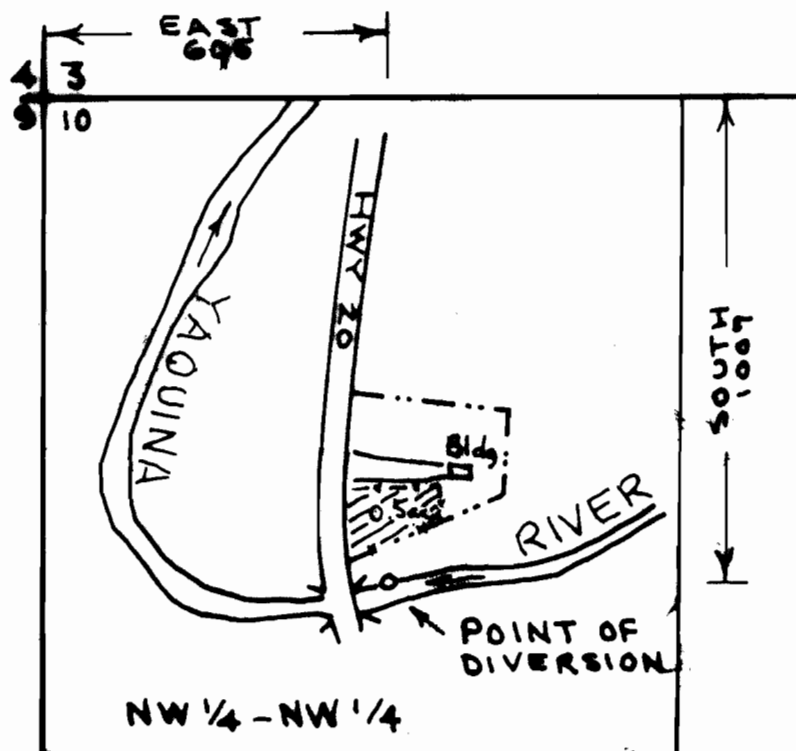

FINAL PROOF SURVEY
UNDER

APPLICATION # 69645

PERMIT # 50659

IN THE NAME OF
LINCOLN COUNTY
SCHOOL DISTRICT

SURVEYED 08-29-91

BY J.M. Denison

This map prepared solely for the purpose of showing location of a water right, and is not intended for use to provide dimensions or location of property ownership lines.

