
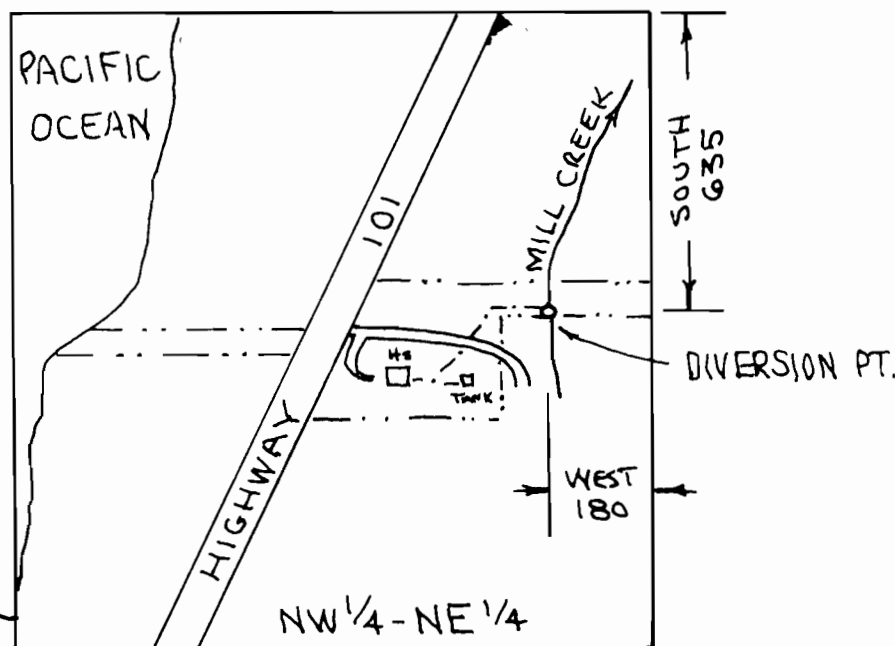


**T.15 S.R.12 W.W.M.
SECTION 34 U.S. LOT 1
LANE COUNTY, OREGON**

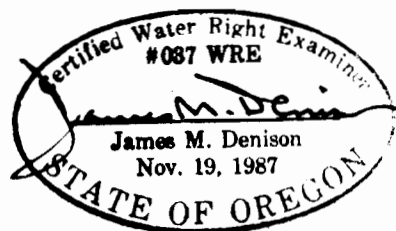

SCALE: 1" = 400'

**FINAL PROOF SURVEY
UNDER**

APPLICATION # 69909

PERMIT # 50703

IN THE NAME OF

Margaret Tetlow

SURVEYED September 18, 1991 BY J. M. Denison

This map prepared solely for the purpose of showing location of a water right, and is not intended for use to provide dimensions or location of property ownership lines.