


T. 9 S. R. 3 E. W. M.



1" = 400'

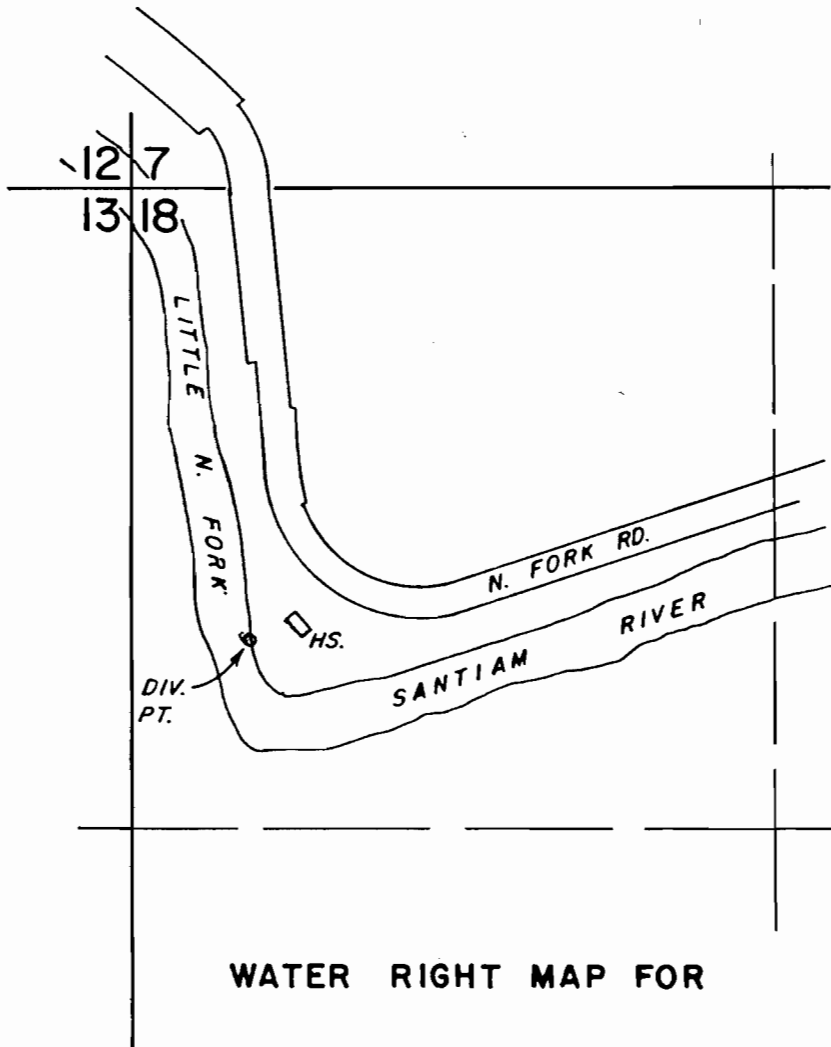

WATER RIGHT MAP FOR  
BRADLEY S. GLAZE

SURVEYED ON MAR. 28, 1992

BY :



THIS MAP WAS PREPARED FOR THE PURPOSE OF IDENTIFYING THE LOCATION OF A WATER RIGHT ONLY AND IS NOT INTENDED TO PROVIDE LEGAL DIMENSIONS OR LOCATION OF PROPERTY OWNERSHIP LINES.

DIV. PT. LOC. 935' S. & 230' E. FROM N.W. COR. SEC. 18