


T. 27 S., R. 14 W., W.M.
COOS COUNTY, OREGON

SECTION 25

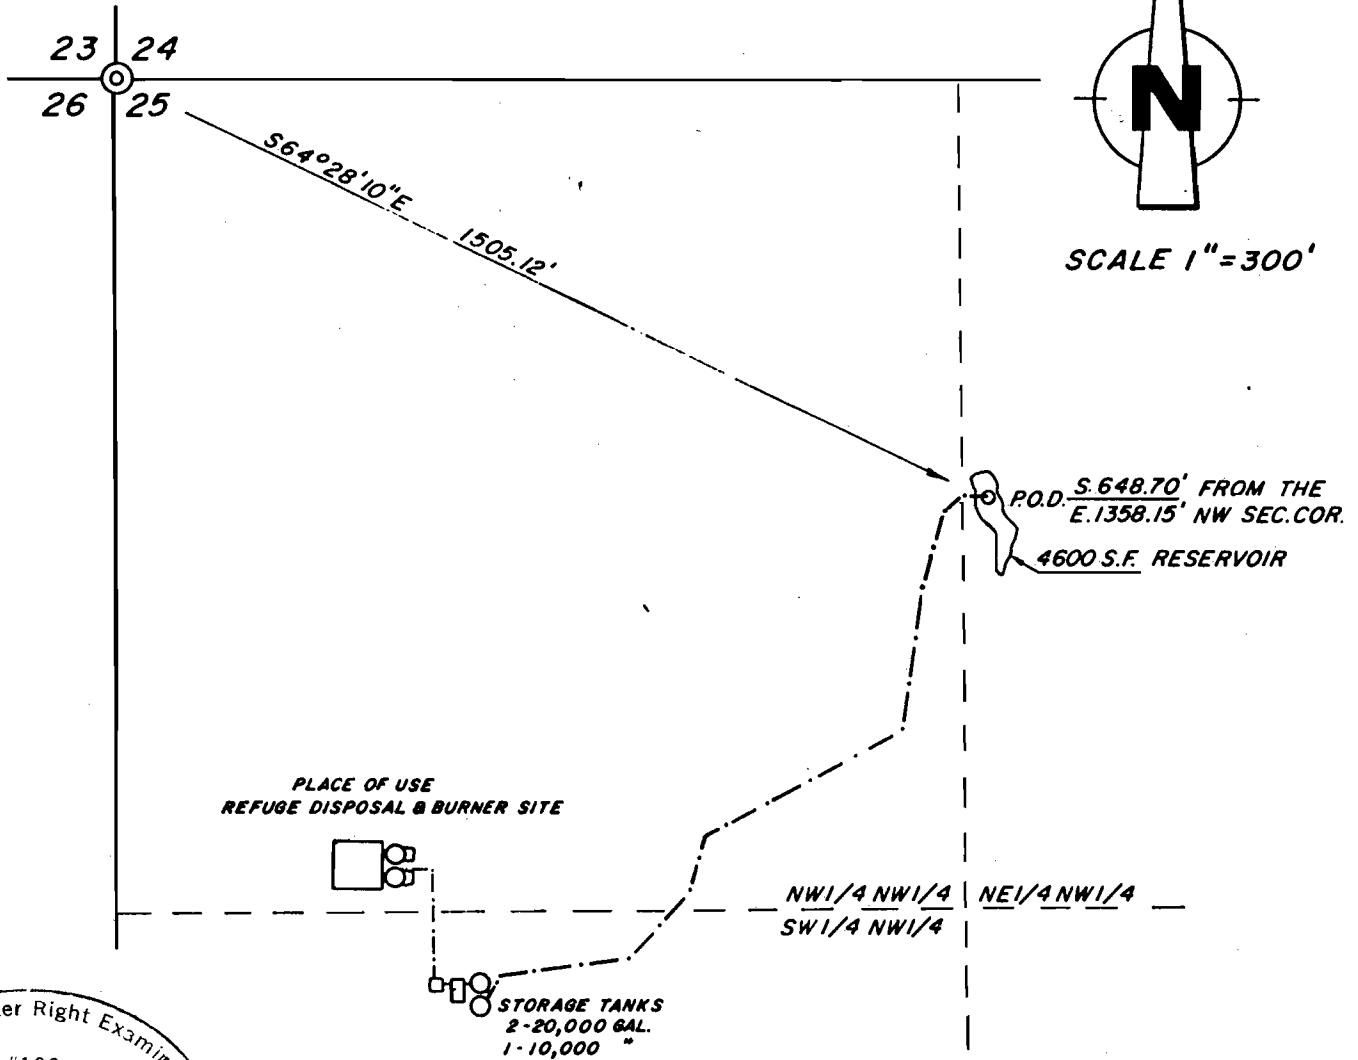

Certified Water Right Examiner
#126
Ronald E. Stuntzner
Ronald E. Stuntzner
Nov. 19, 1987
STATE OF OREGON

FINAL PROOF SURVEY

UNDER APPLICATION #'S 70174 AND R-70173
PERMIT #'S 50941 AND R-11200

IN THE NAME OF
COOS COUNTY BOARD OF COMMISSIONERS

SURVEYED SEPT. 28, 1991, BY R.E. STUNTZNER (CWRE)

Supplanted

EXAMINERS DISCLAIMER STATEMENT

THE PREPARATION OF THIS MAP WAS FOR THE PURPOSE OF IDENTIFYING THE LOCATION OF THE WATER RIGHT ONLY AND HAS NO INTENT TO PROVIDE DIMENSIONS OR LOCATION OF PROPERTY OWNERSHIP LINES.

PREPARED BY:

Stuntzner Engineering & Forestry

TELEPHONE 287-2872

705 SO. 4TH, P.O. BOX 118 - COOS BAY, OREGON 97430