


FINAL PROOF SURVEY MAP

IN THE NAME OF CROFT LAKE ASSOCIATION

SECTIONS 10, 11, 14, AND 15, T30S, R15W, W.M.
APPLICATION R-70188 PERMIT R-1 1245
APPLICATION 70189 PERMIT 51064



1 INCH = 1320 FEET

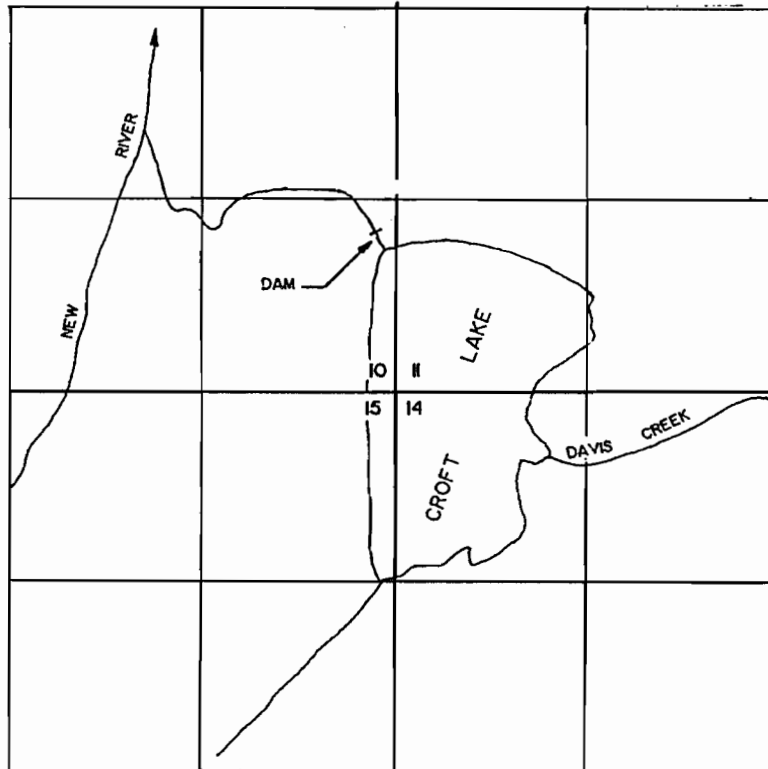

THE DAM IS LOCATED 1070 FEET NORTH AND 130 FEET WEST FROM THE SOUTHEAST CORNER OF SECTION 10, BEING WITHIN THE SOUTHEAST 1/4 OF THE SOUTHEAST 1/4 OF SECTION 10, TOWNSHIP 30 SOUTH, RANGE 15 WEST, W.M., COOS COUNTY.

THE PURPOSE OF THIS MAP IS TO IDENTIFY THE LOCATION OF THE WATER RIGHT. IT IS NOT INTENDED TO PROVIDE INFORMATION RELATIVE TO THE LOCATION OF PROPERTY OWNERSHIP BOUNDARY LINES.

