

FINAL PROOF SURVEY MAP

IN THE NAME OF EARL M. AND JANELLE M. MC CORMACK


SECTION 11, TOWNSHIP 26 SOUTH, RANGE 3 WEST, W.M.



1 INCH = 1320 FEET

APPLICATION 70363

PERMIT 51297

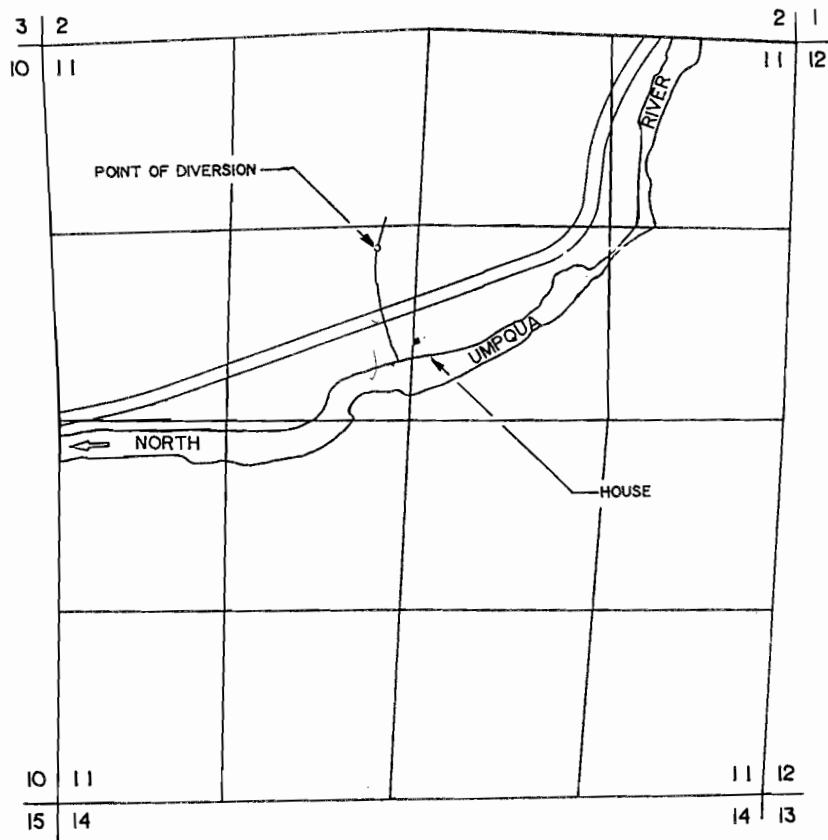

THE POINT OF DIVERSION IS LOCATED 3810 FEET NORTH AND 2280 FEET EAST FROM THE SOUTHWEST CORNER OF SECTION 11, BEING WITHIN THE SE 1/4 OF THE NW 1/4 OF SECTION 11, TOWNSHIP 26 SOUTH, RANGE 3 WEST, W.M., DOUGLAS COUNTY.

THE PURPOSE OF THIS MAP IS TO IDENTIFY THE LOCATION OF THE WATER RIGHT. IT IS NOT INTENDED TO PROVIDE INFORMATION RELATIVE TO THE LOCATION OF PROPERTY OWNERSHIP BOUNDARY LINES.

