



T. 17 S., R. 8 W., W. M.
SECTION 3

THIS MAP IS FOR
THE PURPOSE OF
LOCATING A WATER
RIGHT AND IS NOT
INTENDED TO PROVIDE
LEGAL DIMENSIONS
FOR LOCATING
BOUNDS.

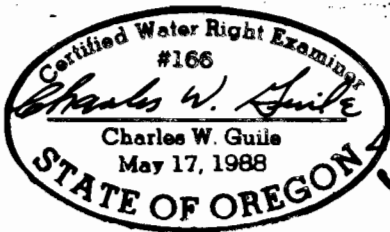

CHARLES W. GUILÉ
& ASSOCIATES, CO.
Land Surveying
52 Centennial Loop
Eugene, OR 97401

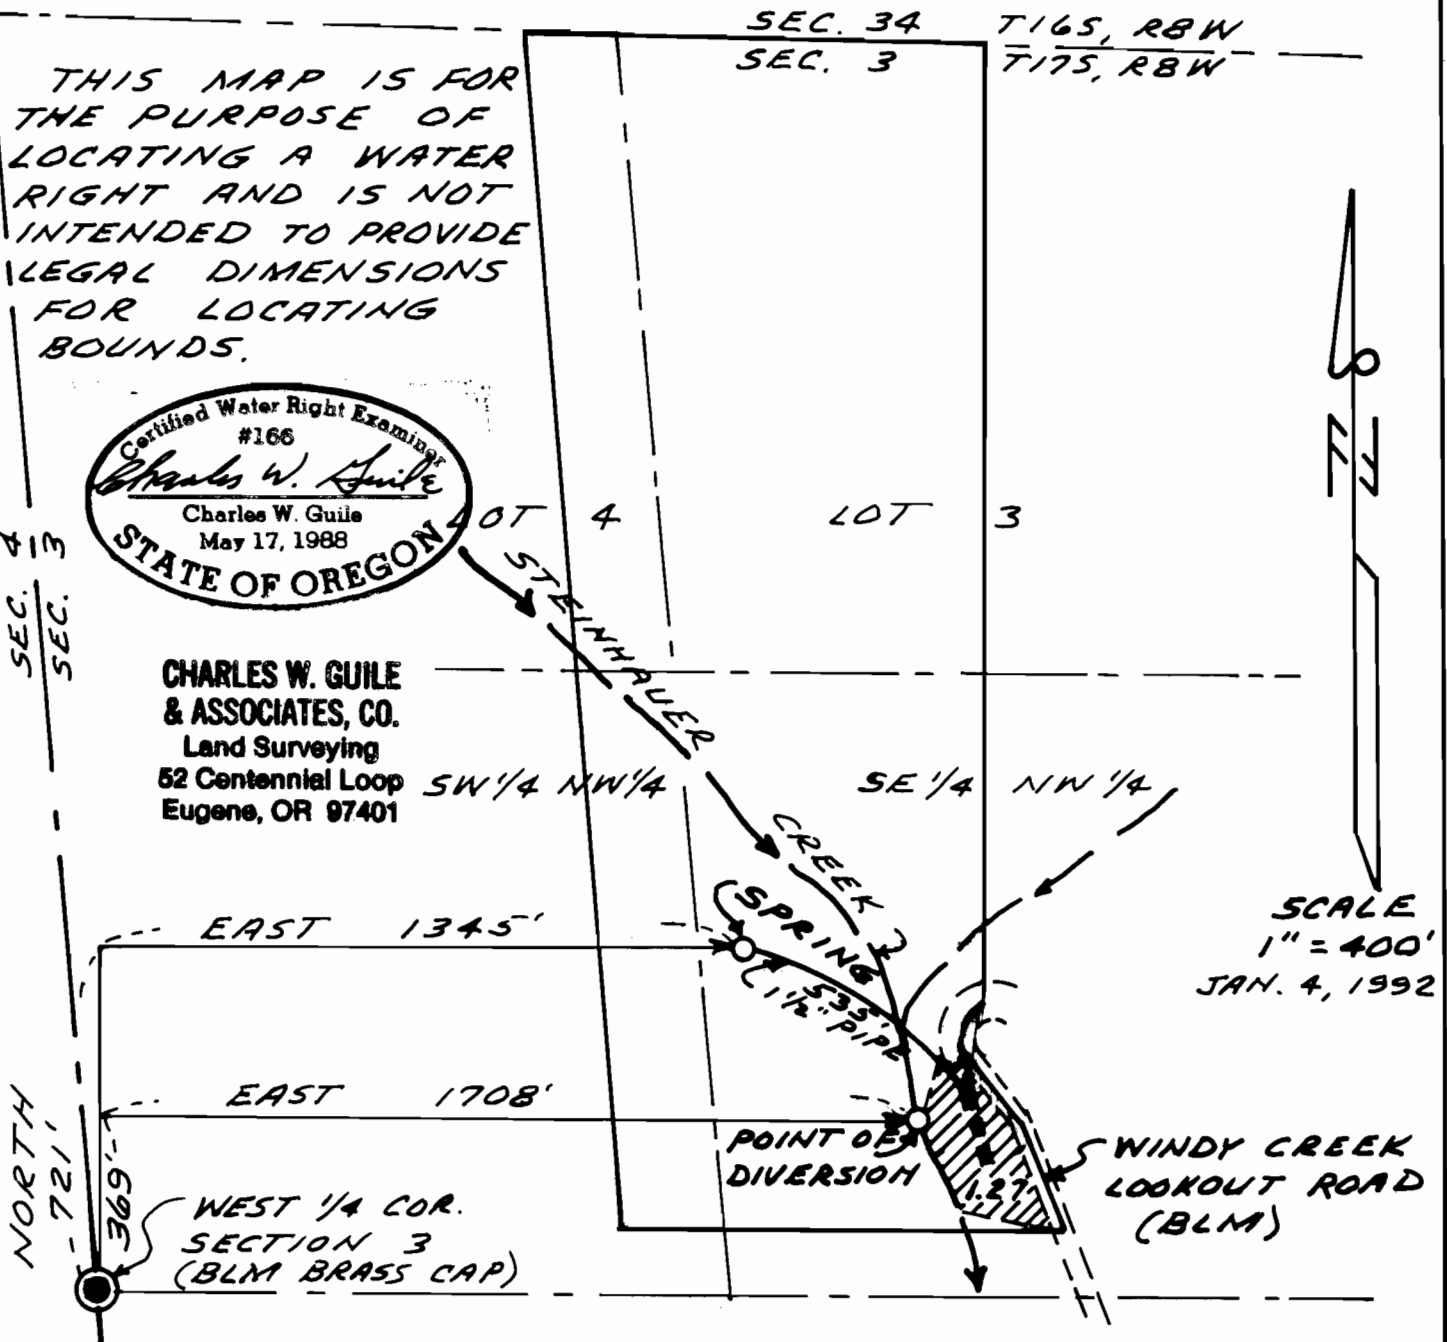

FINAL PROOF SURVEY
UNDER

APPLICATION NO. 70723, PERMIT NO. 51183.

IN NAME OF

STEVE STEINHAUSER

SURVEY: DECEMBER 10, 1991 BY CHARLES W. GUILÉ

90-53