


T26S.R4W.WM

SCALE 1" = 1320'

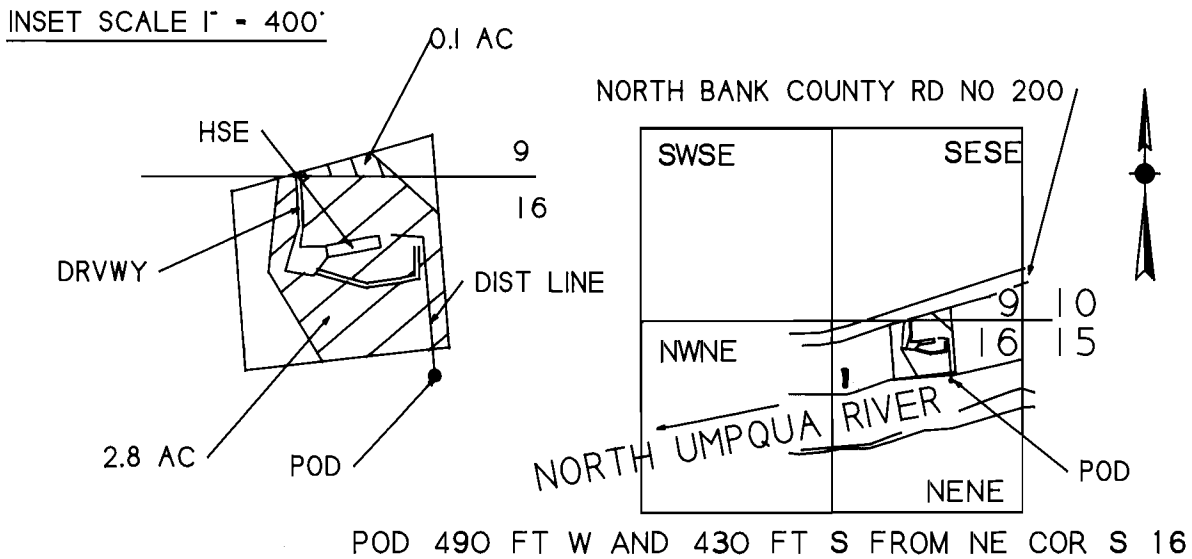

FINAL PROOF SURVEY


UNDER

Application No. 70735 Permit No. 51156

IN NAME OF

Ronald G or W Kay Bilton

Surveyed July 18, 1991, by M E Farr

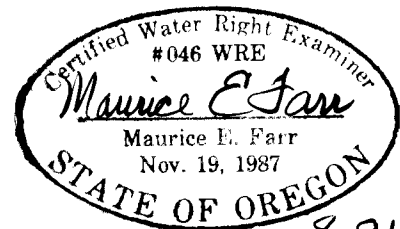

8-91