


RECEIVED


FEB 25 1992

WATER RESOURCES DEPT
SALEM, OREGON

T.11 S.R.11 W.W.M.
LINCOLN COUNTY, OREGON

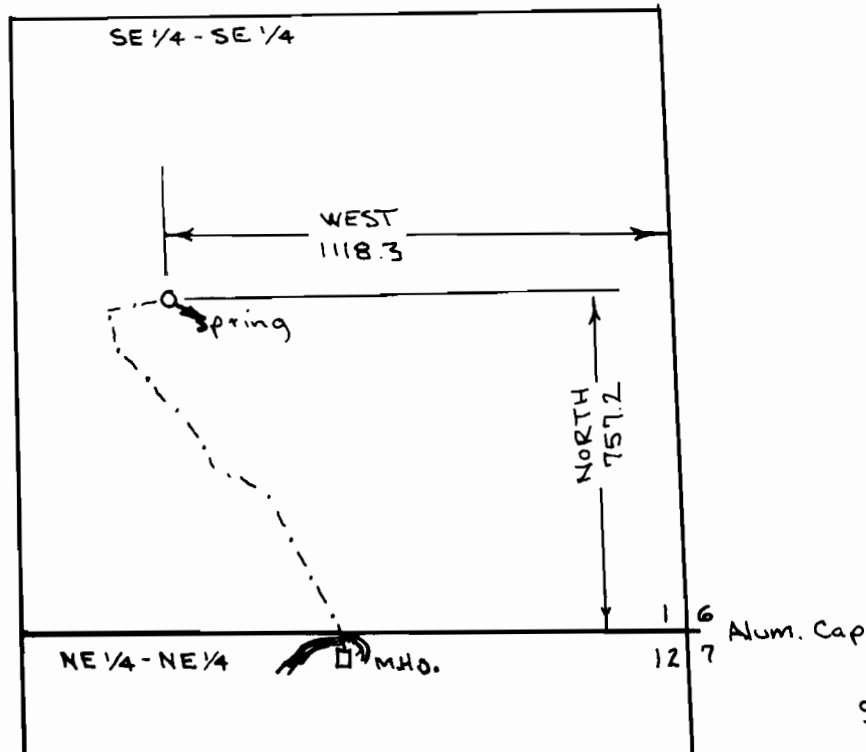

FINAL PROOF SURVEY
UNDER

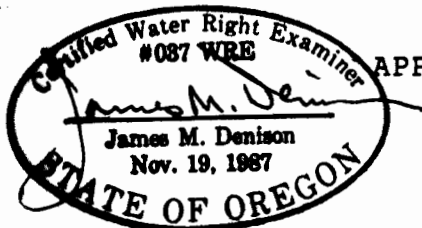

APPLICATION # 70795

PERMIT # 51185

IN THE NAME OF

OLIVER A. WETTEN

SURVEYED January 3, 1992

BY James M. Denison

This map prepared solely for the purpose of showing location of a water right, and is not intended for use to provide dimensions or location of property ownership lines.