

RECEIVED

JAN 24 1987

WATER RESOURCES DEPT.  
SALEAS

FINAL PROOF SURVEY MAP

IN THE NAME OF GORDON KIGHT


SECTION 8, T28S, R13W, W.M.



1 INCH = 1320 FEET

APPLICATION 70843

PERMIT 51310

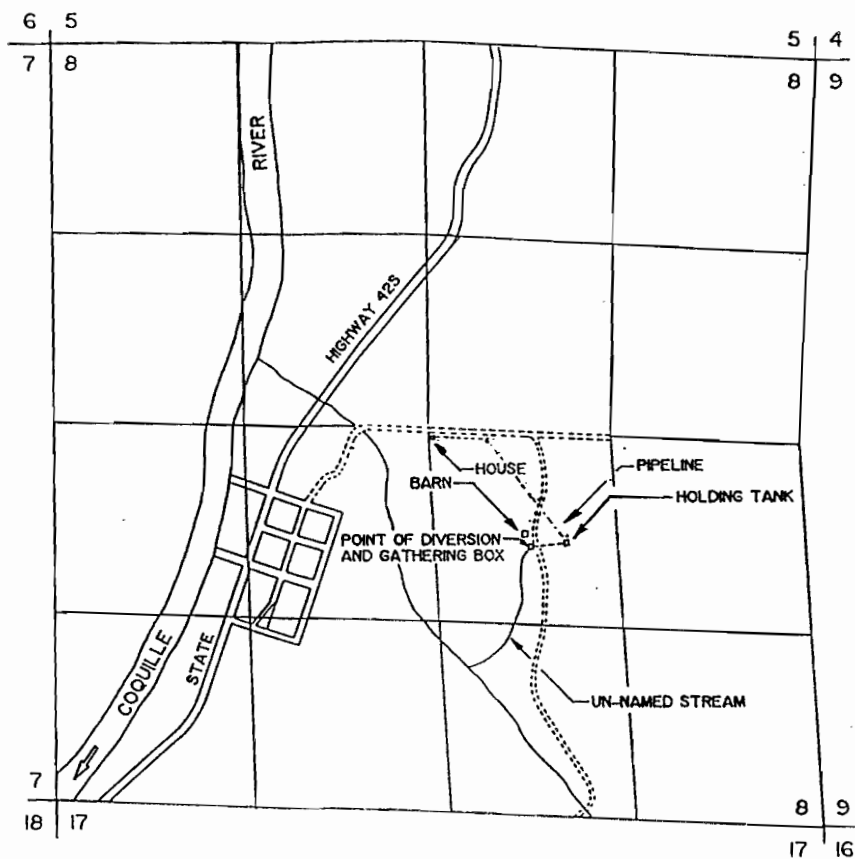

THE POINT OF DIVERSION IS LOCATED 500 FEET SOUTH AND 1950 FEET WEST FROM THE EAST 1/4 CORNER OF SECTION 8, BEING WITHIN THE NW 1/4 OF THE SE 1/4 OF SECTION 8, TOWNSHIP 28 SOUTH, RANGE 13 WEST, W.M., COOS COUNTY.

THE PURPOSE OF THIS MAP IS TO IDENTIFY THE LOCATION OF THE WATER RIGHT. IT IS NOT INTENDED TO PROVIDE INFORMATION RELATIVE TO THE LOCATION OF PROPERTY OWNERSHIP BOUNDARY LINES.

