


T.24S., R.11W., WM.

FINAL PROOF SURVEY



under
Application No. 71637
Permit No. 51303
in name of
CHICK A. KYSAR

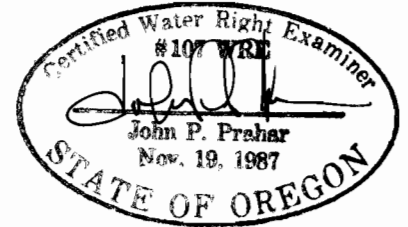

Surveyed Dec 31, 1991 by John P. Prahar CWRE# 107

