


7165
67871
T4660

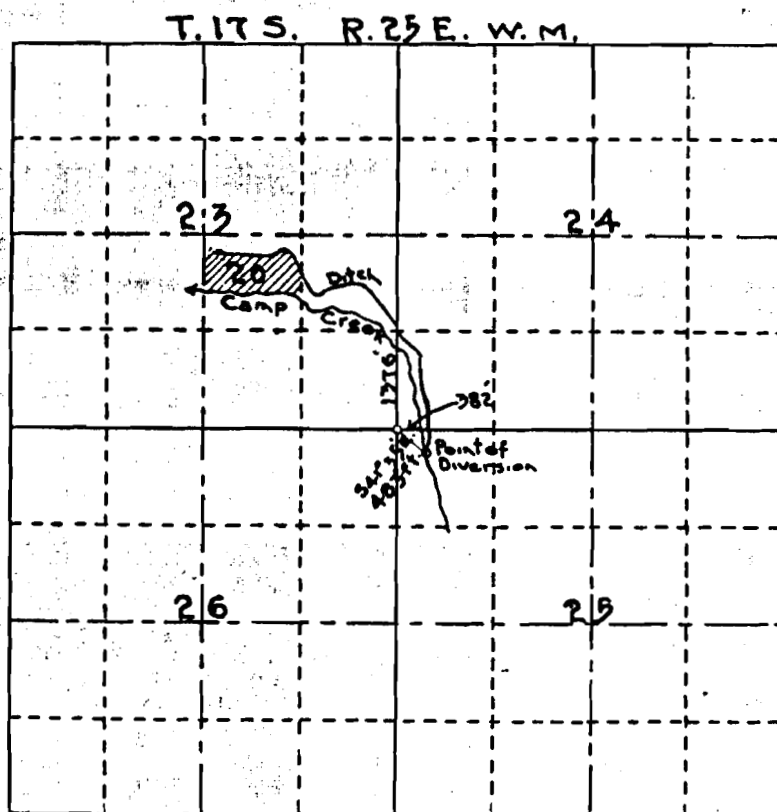

MAP
OF
John Delore Ditch
July, 3, 1915 Scale 2"=1 Mile

I, H.A. Kelley, of Prineville, Oregon, do hereby certify that this map was made from notes taken during an actual survey made by me on July, 3rd, 1915, and that it correctly represents the works described in the accompanying application, together with the location of streams and other ditches in the immediate vicinity, and has written thereon the area in each smallest legal subdivision which it is proposed to irrigate

H.A. Kelley
Surveyor

Application No. 6050
Permit No. 3776

P-3776