


# T.36S.R.6E.W.M.

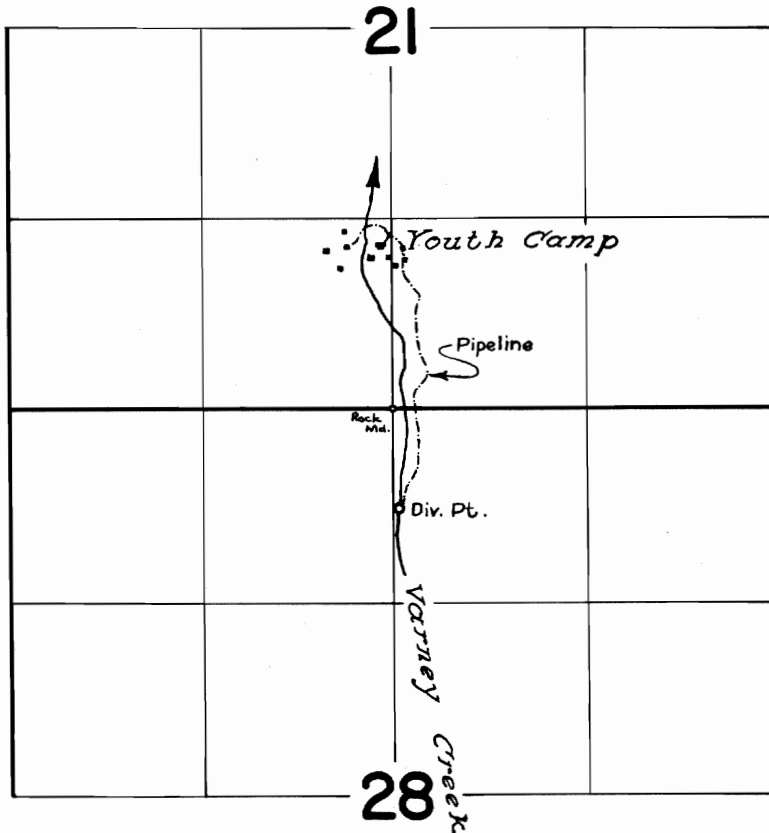

## FINAL PROOF SURVEY UNDER

Application No. 34608 Permit No. 27174  
IN NAME OF

UNITED STATES of AMERICA, Forest Service

Surveyed August 14 1962, by *H. Jackson*