


T. 2N. R. 27E. W.M.

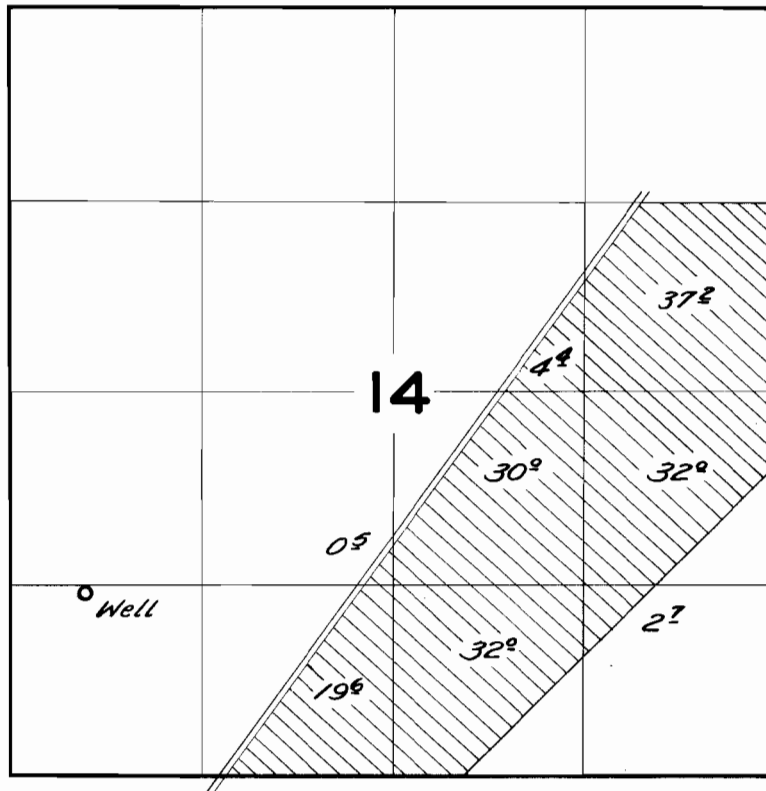

FINAL PROOF SURVEY
UNDER

Application No. *LL-587* Permit No. *LL-536*
IN NAME OF

Oscar D. McCarty

Surveyed *May 28* 1957 by *C.O. Curtis*