


T.7S. R.4W.W.M.

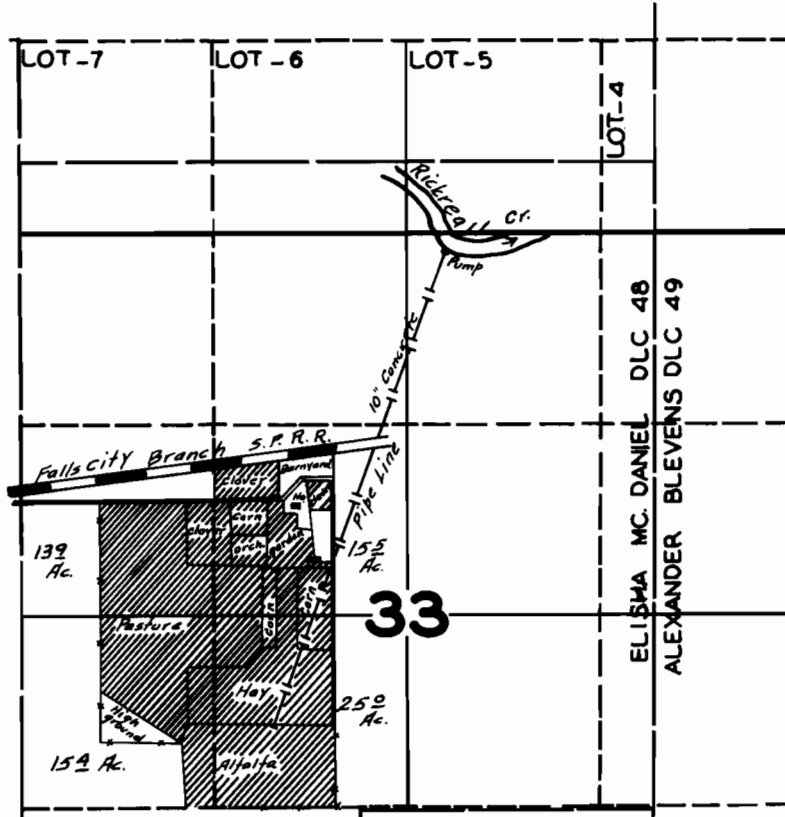

FINAL PROOF SURVEY UNDER

Application No. 16799 Permit No. 12571

IN NAME OF

C. J. JENKINS

Surveyed JULY 21 1944, by *[Signature]*