


T. 9 S. R. 19 & 20 E. W.M.

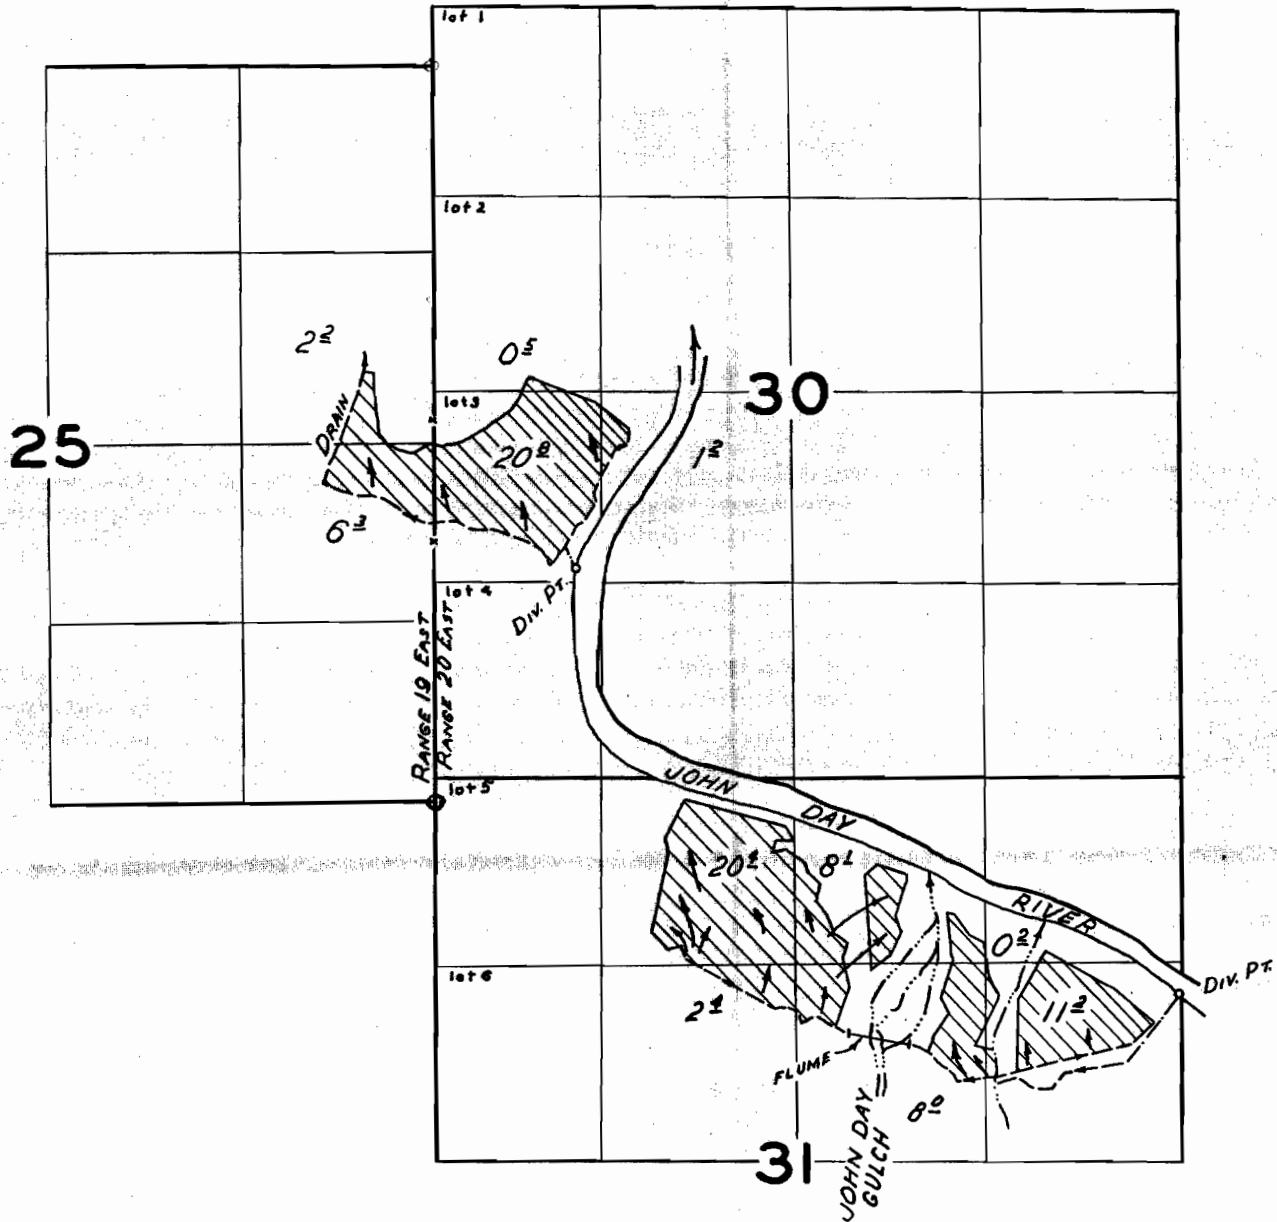

FINAL PROOF SURVEY UNDER

Application No. 31473 Permit No. 24814
IN NAME OF

James M. Morrison & Andrew A. Norton

Surveyed SEP 29 1962, by R. JACKSON