


T. 36 S., R. 6 W., W. M.

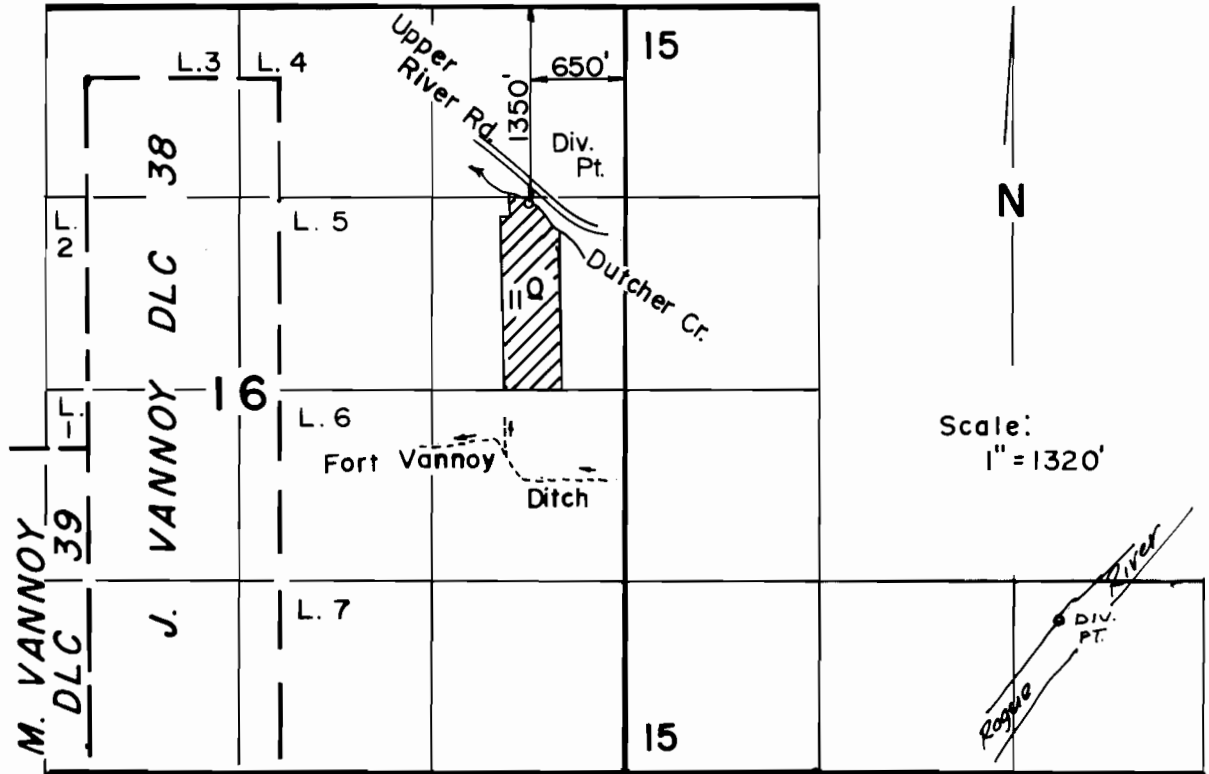

Div. Pt., Ft. Vannoy Irr. Dist. = N. 71° E. 3150' from
 (T.36S., R.6W., W.M.) S.W. Cor. of Sec. 15, in
 S.W. 1/4 S.E. 1/4

FINAL PROOF SURVEY

UNDER

60533 46006

62988 46647

Application No. 64546 Permit No. 47238...

IN NAME OF

CHARLES K. JENNER

Surveyed SEP. 15. 19.8.7, by B. S. JAMES...