

Appl 10485

7147

6789

Correction Plat


FRED FRAIN COPCO, CALIFORNIA.

For Final Proof to waters of Fall Creek

Jackson County, Oregon. Application 10485

Permit 7147

October 29th 1926.

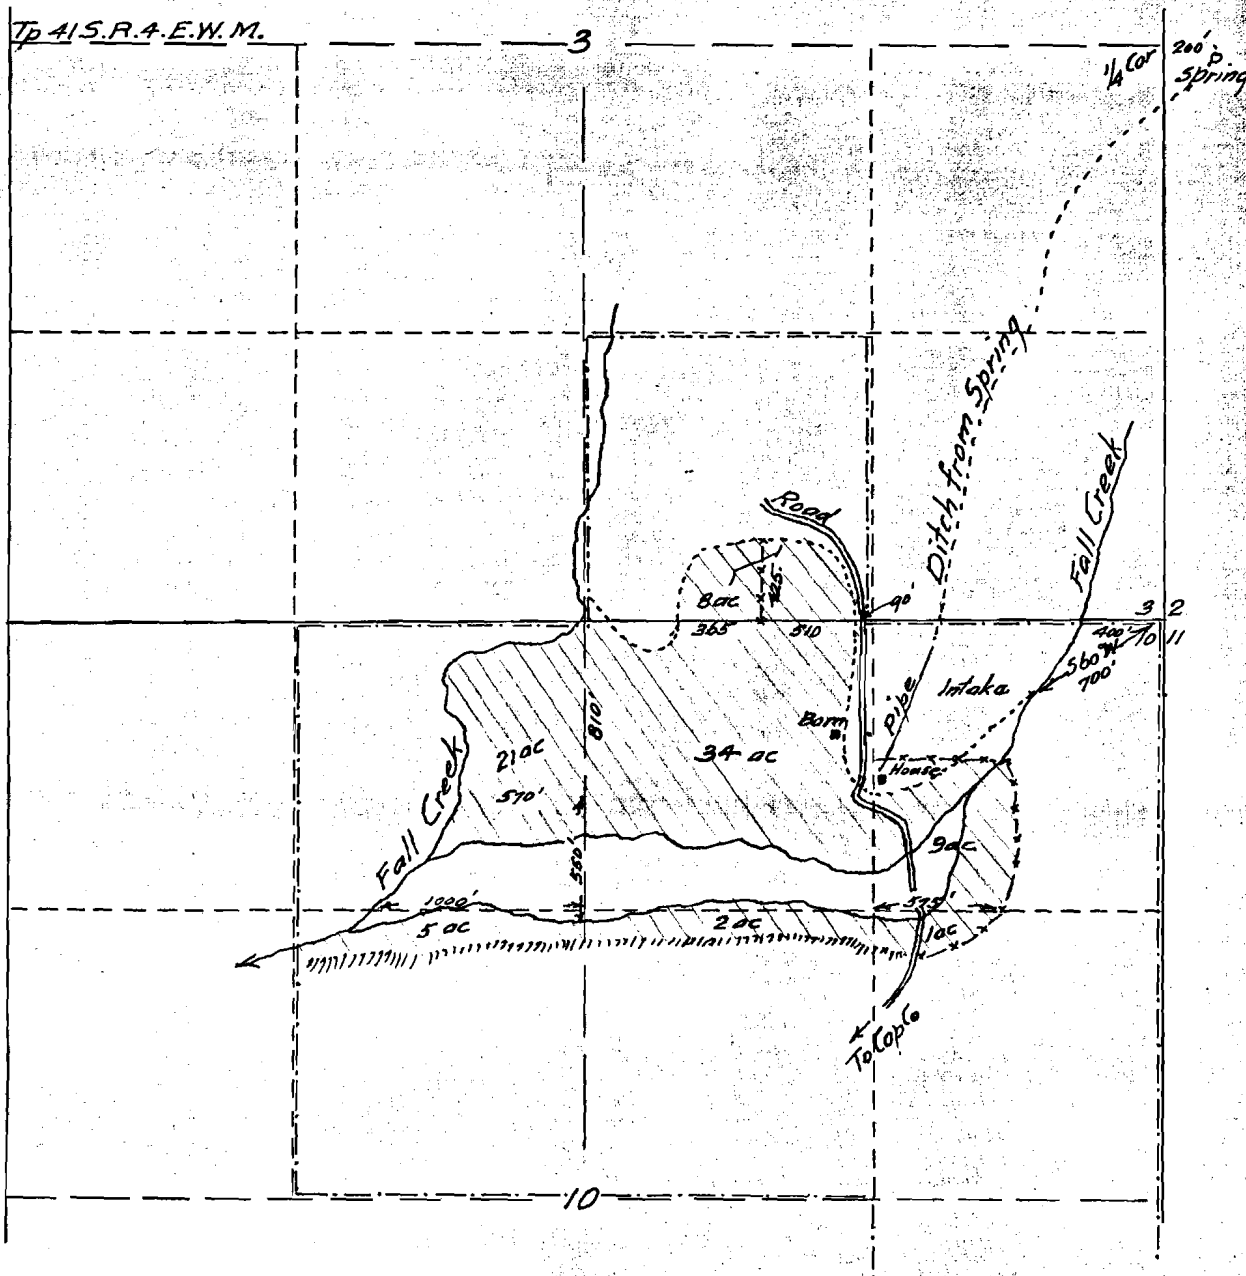

Examined and measured in the field for Final Proof. October 29th
by Fred. N. Cummings. C.E.

guy ab. nuc.