


T. 40 S., R. 12 E., W. M.

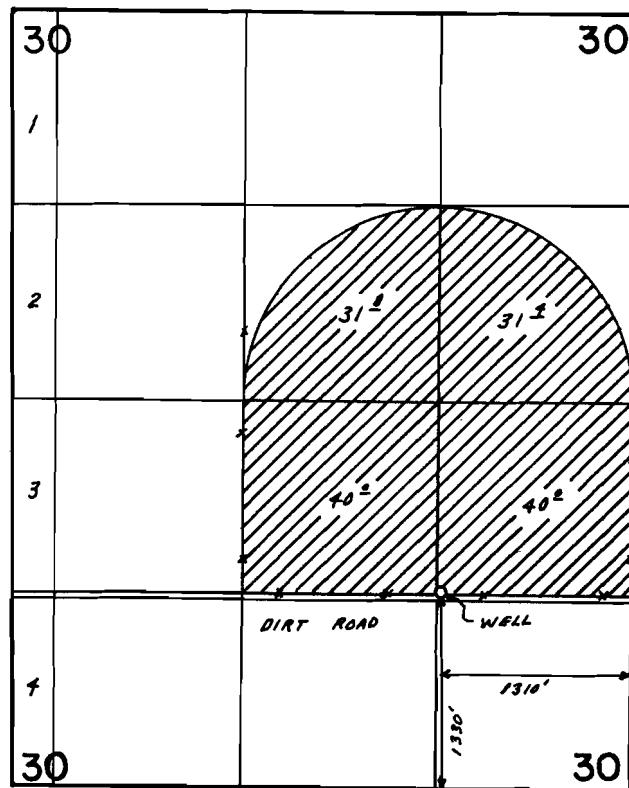

SCALE: 1" = 1320'

**FINAL PROOF SURVEY**  
UNDER

Application No. ~~G-9659~~ Permit No. ~~G-8990~~.....  
IN NAME OF

WARREN D. & ANNA HAUGHT

Surveyed AUG. 20, 1987, by V. L. CHURCH.....

*East River Wells*