


T. 1 S., R. 3 W., W.M.

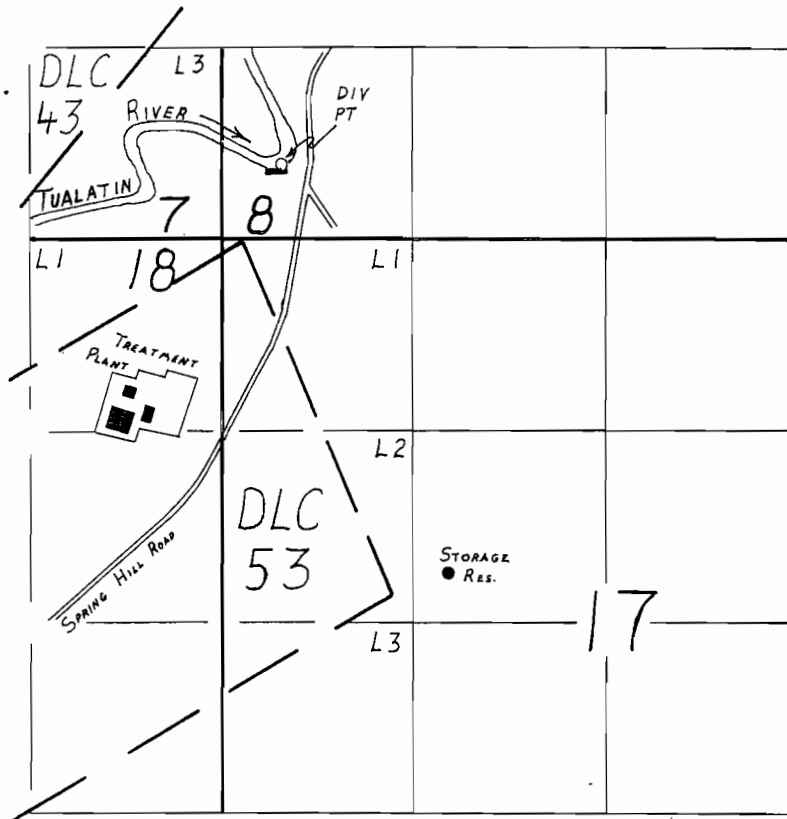

DIV. PT. LOCATION: 500' NORTH and 410' EAST
FROM THE SOUTHWEST CORNER,
SECTION 8.

FINAL PROOF SURVEY

UNDER

Transfer Number 3130

IN NAME OF

CITY OF HILLSBORO

Surveyed AUGUST 8, 1986, by B.W. BISHOP