


T. 35S., R. 11W., W.M.

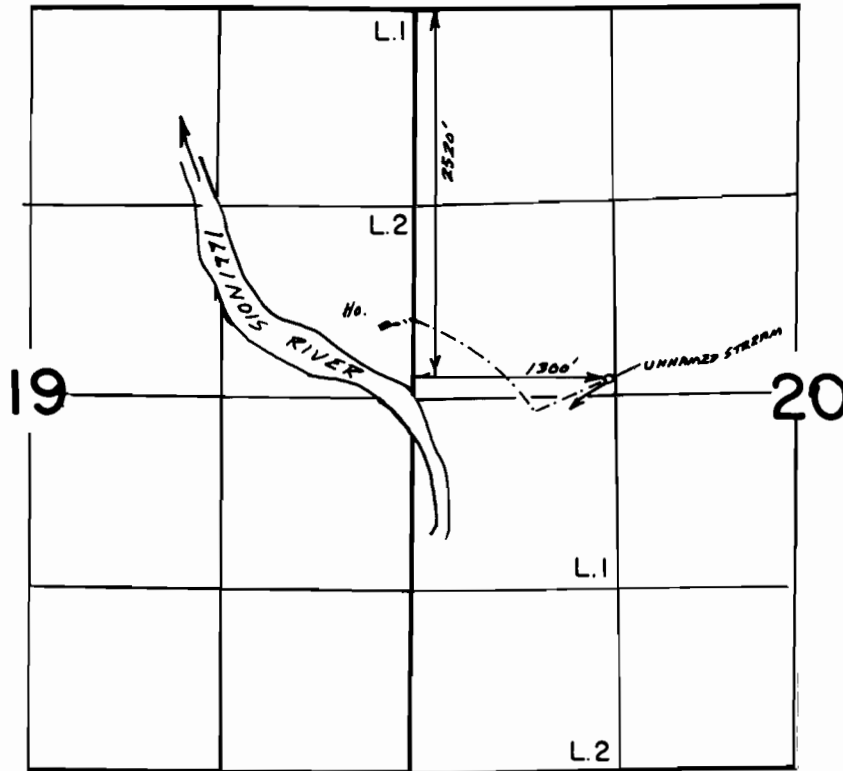

Scale 1"=1320'

FINAL PROOF SURVEY
UNDER

Application No. 60380 Permit No. 45137.....
IN NAME OF

.....EMMETT.....RUSSELL.....McINTOSH

Surveyed July.13. 1989, by B.S.JAMES.....