


T.33S., R.31E., W.M. HARNEY CO., ORE.

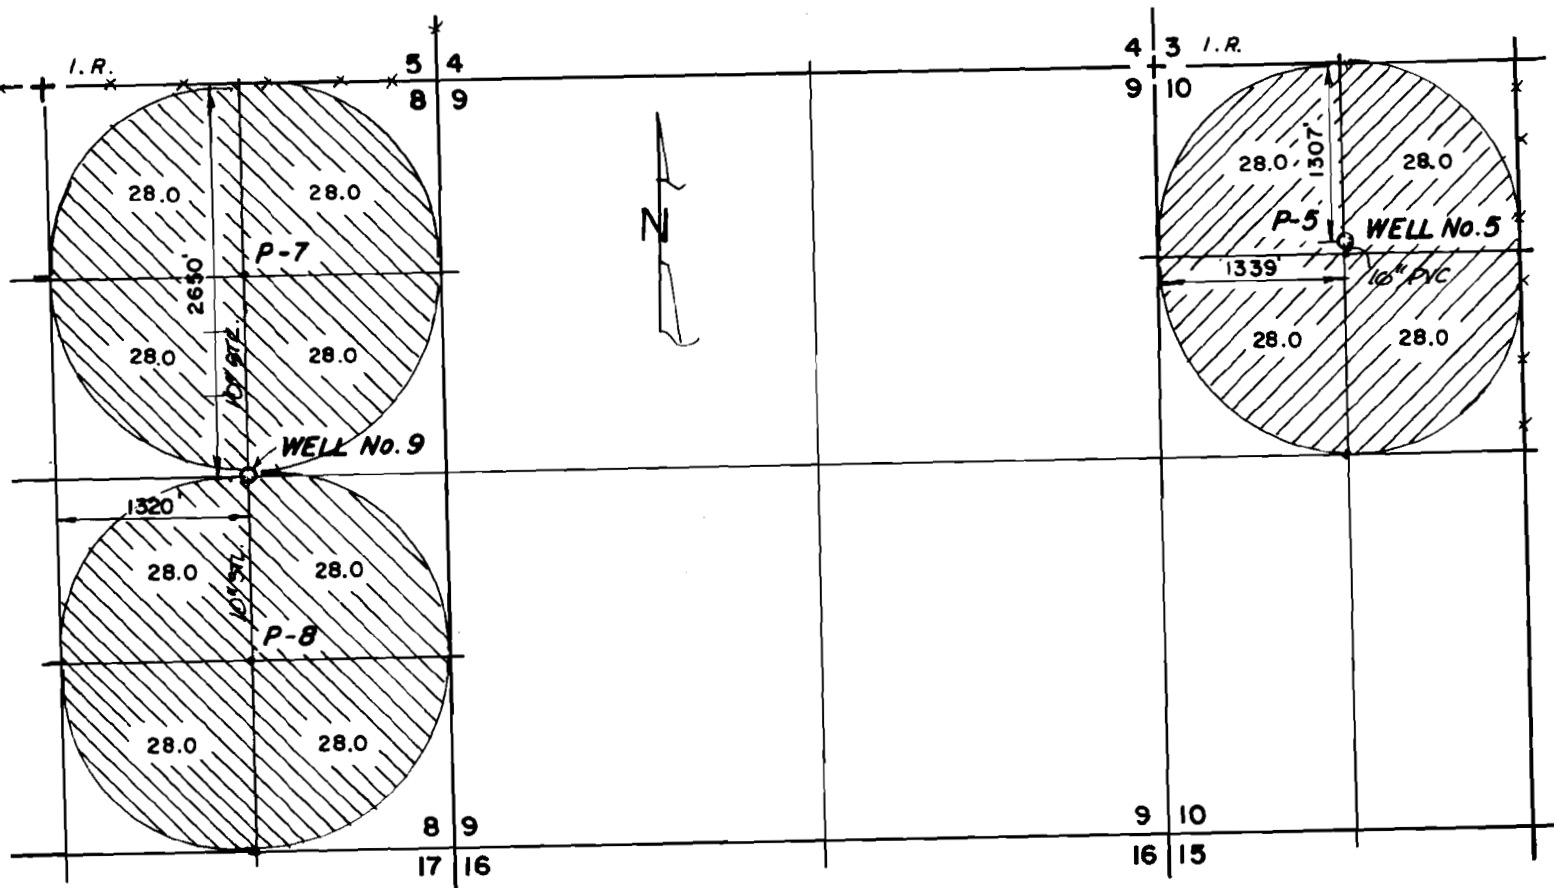


PERMIT G-10872, APPL. G-11858



PERMIT G-10873, APPL. G-11859

IN THE NAME OF: VALMONT INDUSTRIES, INC.
W. HWY. 275
VALLEY, NEBRASKA 68064

THE PURPOSE OF THIS MAP IS TO
IDENTIFY THE LOCATION OF THE
WATER RIGHT. IT IS NOT INTENDED
TO PROVIDE INFORMATION RELATIVE
TO THE LOCATION OF PROPERTY
OWNERSHIP.

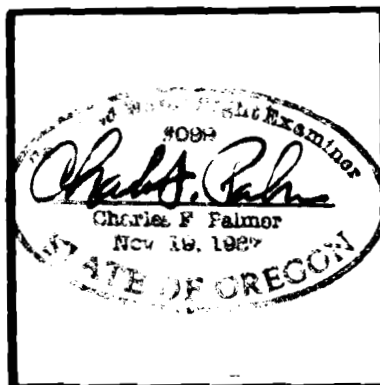

CARL THOMAS

LAS VEGAS, NEV.

FINAL PROOF MAP

IN SEC. 8 & 10 OF T. 33 S., R. 31 E., W. M., HARNEY CO., ORE.

Scale: 1" = 1320'

Date: FEB. 24, 1992

Job: 1224-92

Dgn: CORK

Drn:

Ckd:



M. A. PALMER & SONS, INC.
ENGINEERING & SURVEYING
254 N. Alder - Box 61
Burns, Oregon 97720

Sht. No.

of 1