



T12S, R6W, W. M.
SECTION 8

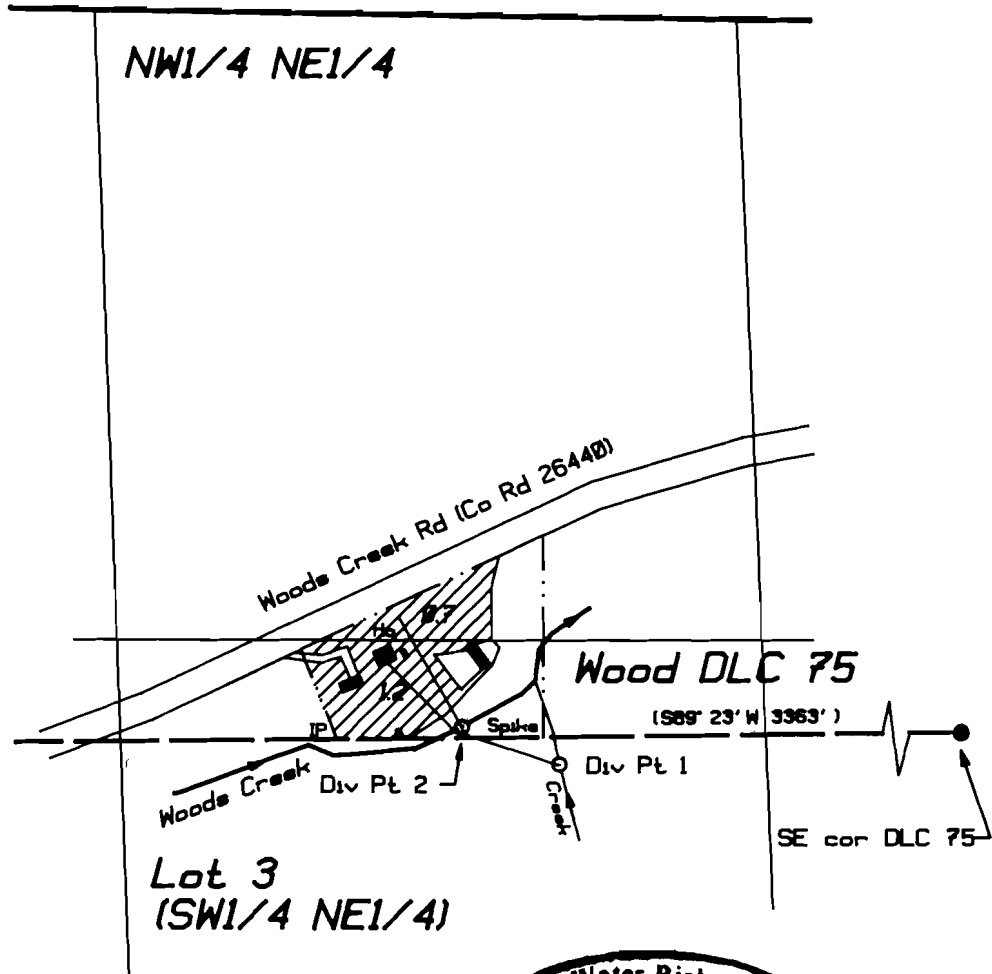

Div Pt 1 - 92' South & 3338' West of
the SE corner Wood DLC 75.
Div Pt 2 - 5' South & 3518' West of
the SE corner Wood DLC 75.

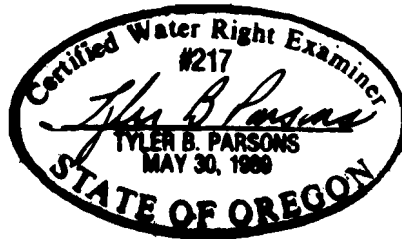

1" = 400'

FINAL PROOF SURVEY

IN THE NAME OF

Daniel H. & Barbara E. Clark

Application No. 69258 Permit No. 50197

Surveyed August 4, 1991

NOTE: Map is for purpose of identifying
location of water right and does not dimension
or locate property ownership lines.

PARSONS SURVEYING
1915 SE Stone St.
Corvallis, OR 97333
(503) 752-7515