



T. 19 S., R. 12 W.W.M.
SECTION II

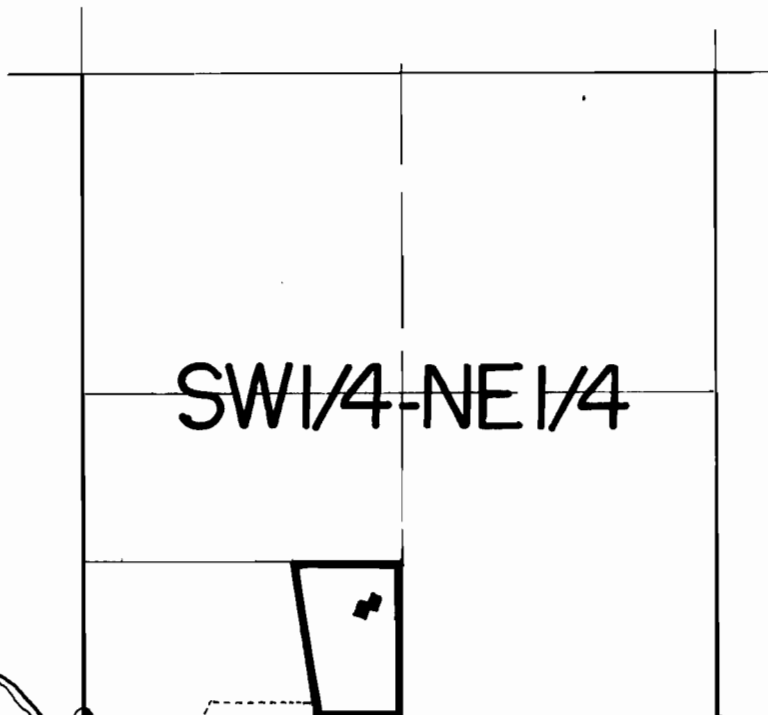

SCALE 1"=400'

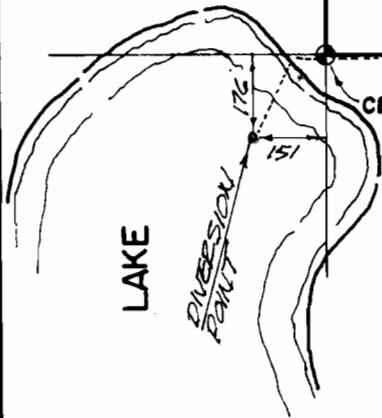

CENTER SEC. II

LAKE

WOAHINK



FINAL PROOF SURVEY

UNDER

APPLICATION NO. 70618 PERMIT NO. 51181

IN NAME OF

ELIZABETH V. OLSEN

SURVEYED JANUARY 4, 1988

BY