


T. 25 S., R. 5 W., W. M.

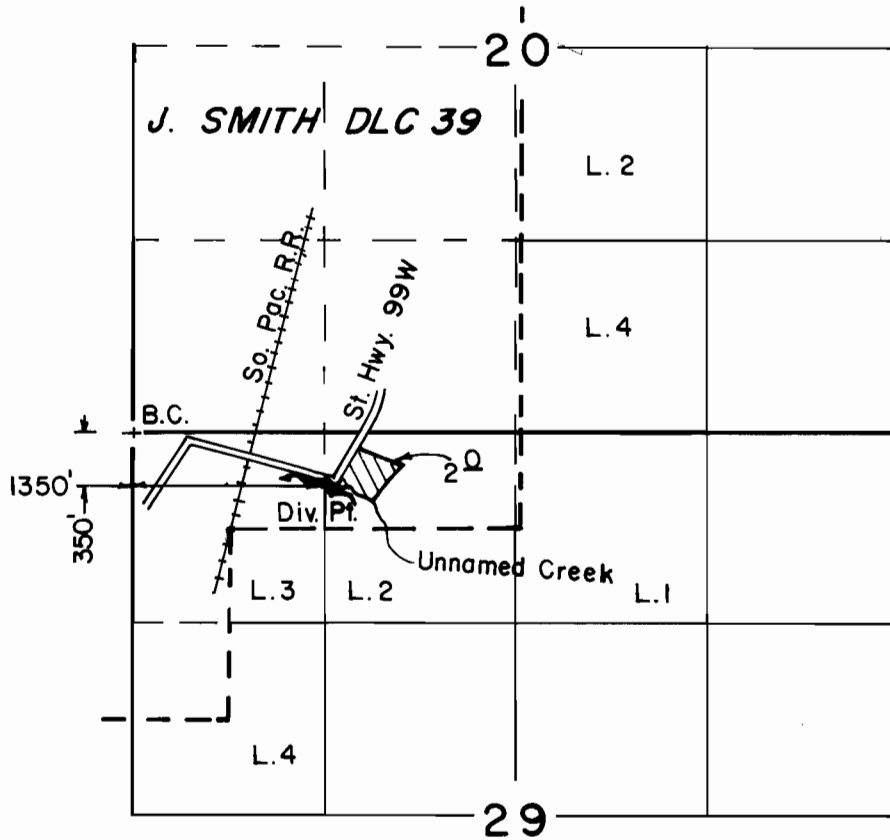

Scale: 1" = 1320'

**FINAL PROOF SURVEY  
UNDER**

Application No. 68475 Permit No. 49448...  
IN NAME OF

.....WALLACE H. TURPIN.....

Surveyed SEP. 12. 1991., by R. S. JAMES...