


T.I.N.&I.S.R. 4 W.W.

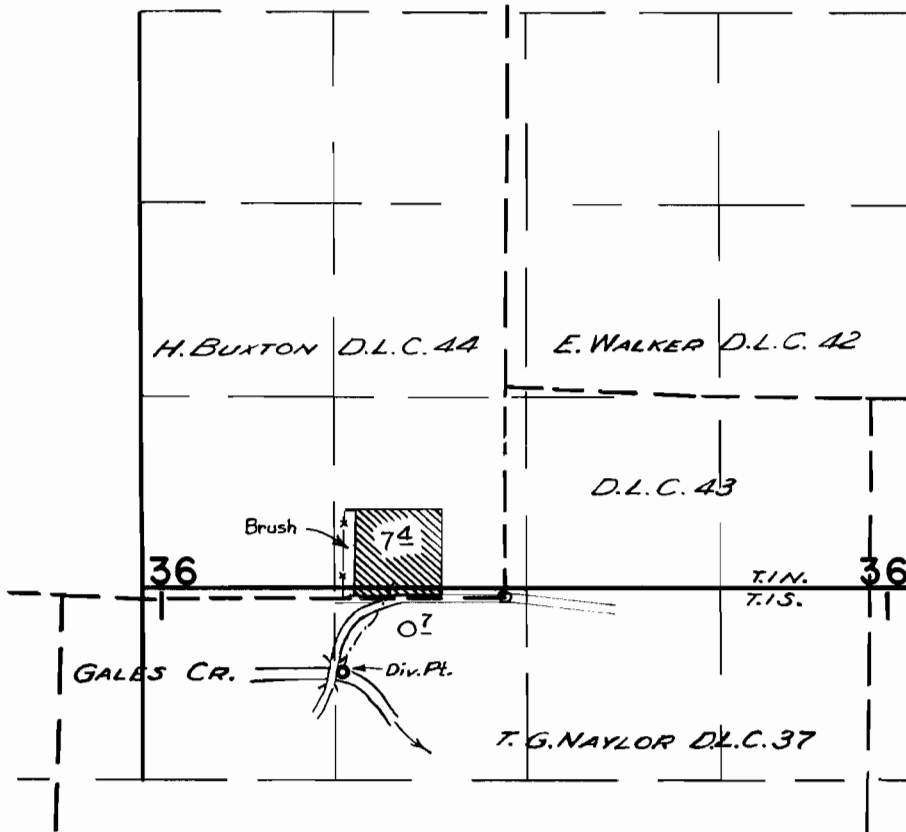

FINAL PROOF SURVEY UNDER

Application No. 10615 Permit No. 7204
IN NAME OF

FOREST VIEW CEMETERY

Surveyed July 18, 1963, by *m. Bishop*