


67904

T. 6N., R. 35E., W. M.

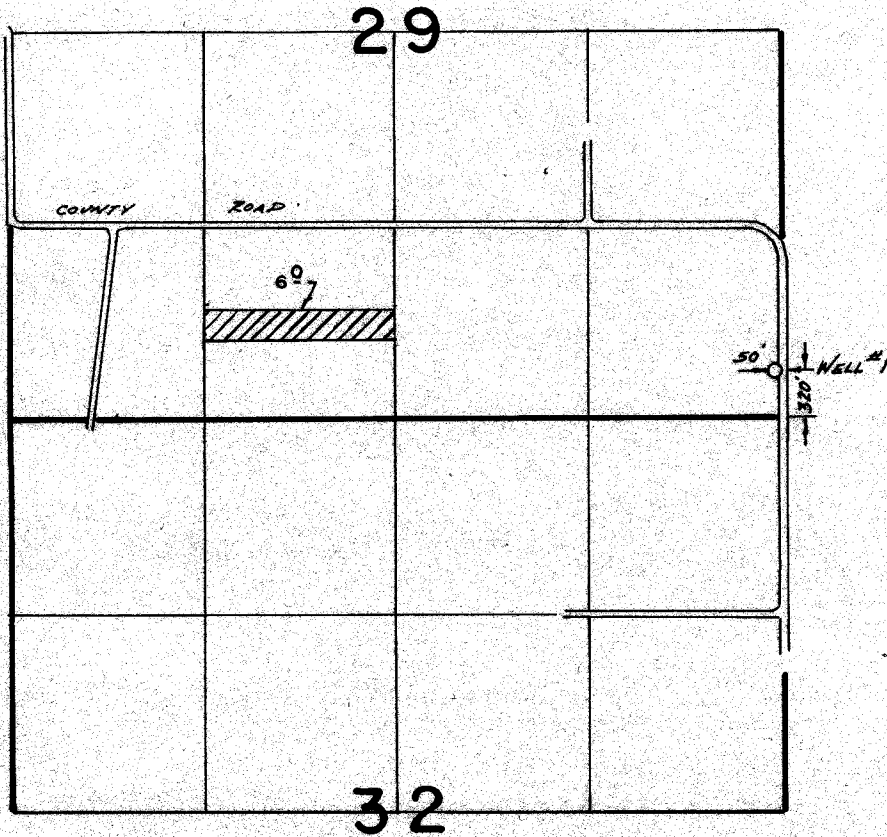

FINAL PROOF SURVEY
 UNDER

Application No. G-8587... Permit No. G-8114.....
 IN NAME OF

BURLINGAME LAND & LIVESTOCK, INC.

Surveyed April 5..... 1982., by V.H. Church.....