


G-9488

T. 1N., R. 32E., W.M.

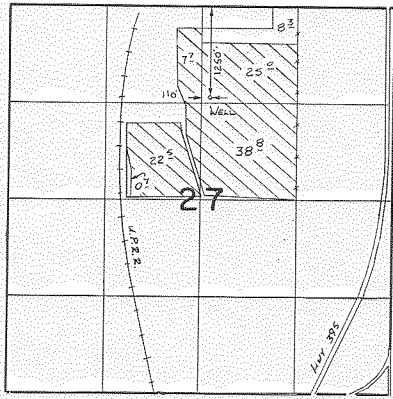

SCALE 1" = 1320'

FINAL PROOF SURVEY
UNDER

Application No. G-9164 Permit No. G-9488
IN NAME OF

FRANKLIN HOEFF

Surveyed 11.4 1988, by V. L. Church