


T.5S., R.12E., W.M.

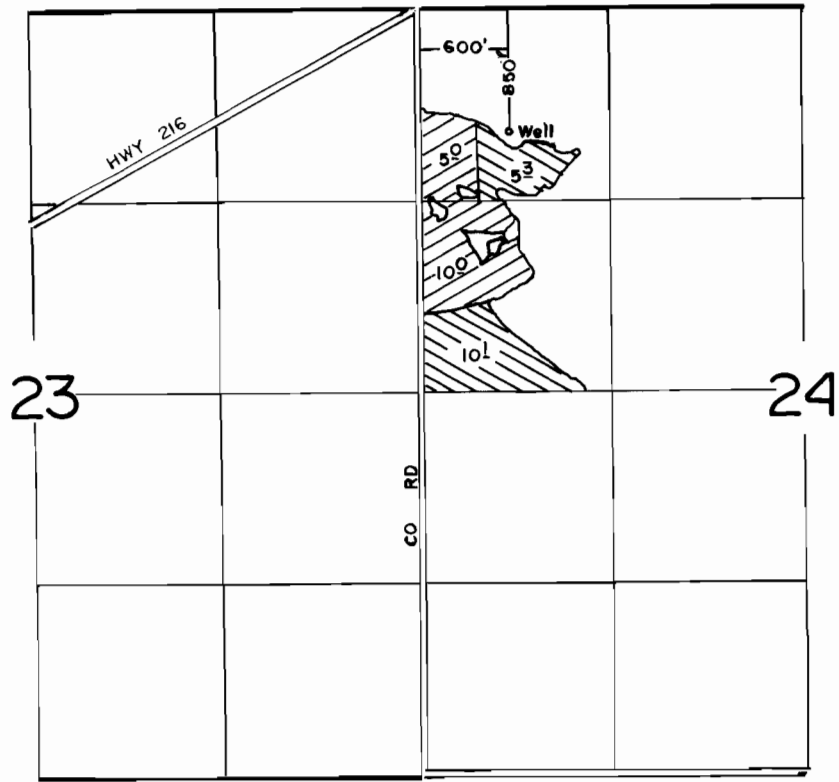

SCALE: 1" = 1320'

FINAL PROOF SURVEY UNDER

Application No. G-11011..... Permit No. G-10181.....
IN NAME OF

HAROLD E. & NANCY H. CARTER.....

Surveyed OCT...18... 1988., by Z.F. SALEH.....

