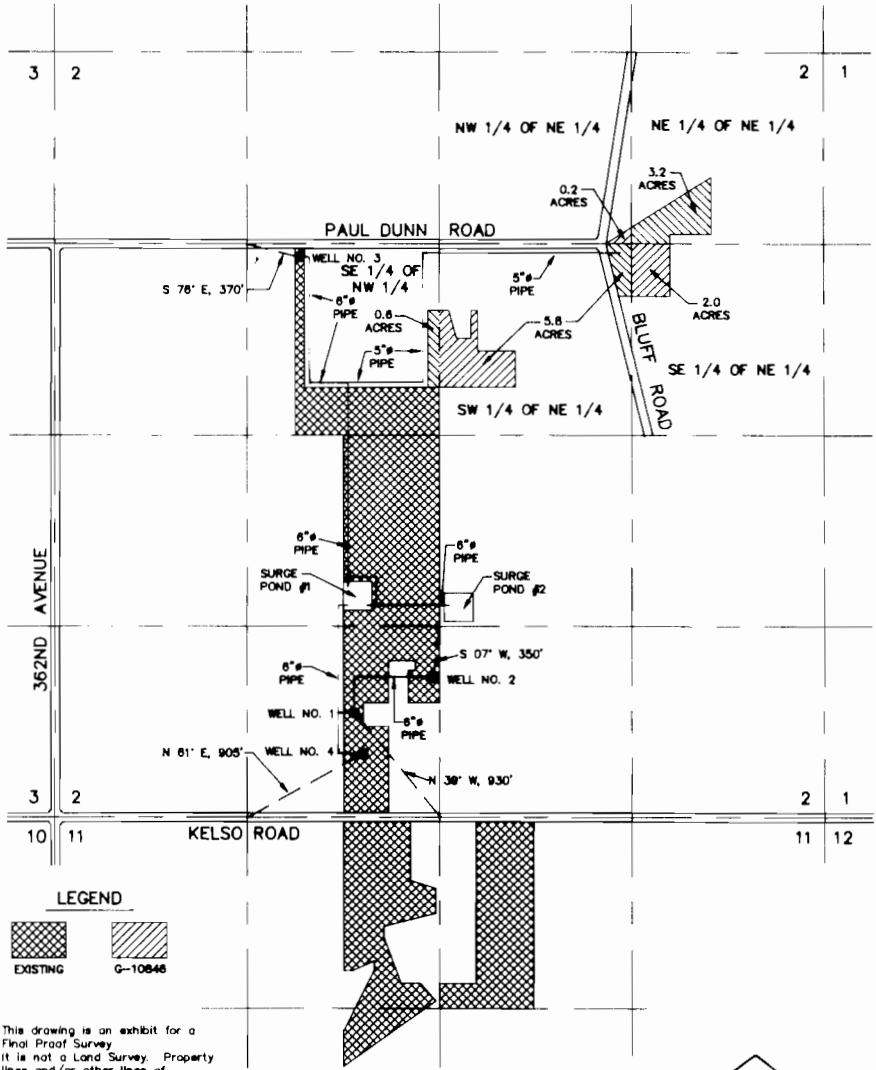

This drawing is an exhibit for a Final Proof Survey. It is not a Land Survey. Property lines and/or other lines of occupation shown hereon are not represented by the undersigned to meet accuracy standards of Land Surveys.

SECTION 2
T.2S., R.4E., W.M.
CLACKAMAS COUNTY, OREGON

Application No.: G-11714
Permit No.: G-10846

HANER, ROSS & SPORSEEN, INC.
15 S.E. 82ND DR.
GLADSTONE, OREGON 97027

CHATELAIN'S NURSERY, INC.
FINAL PROOF SURVEY
FILE: 614/N