



T.16S., R.19E., W. M.

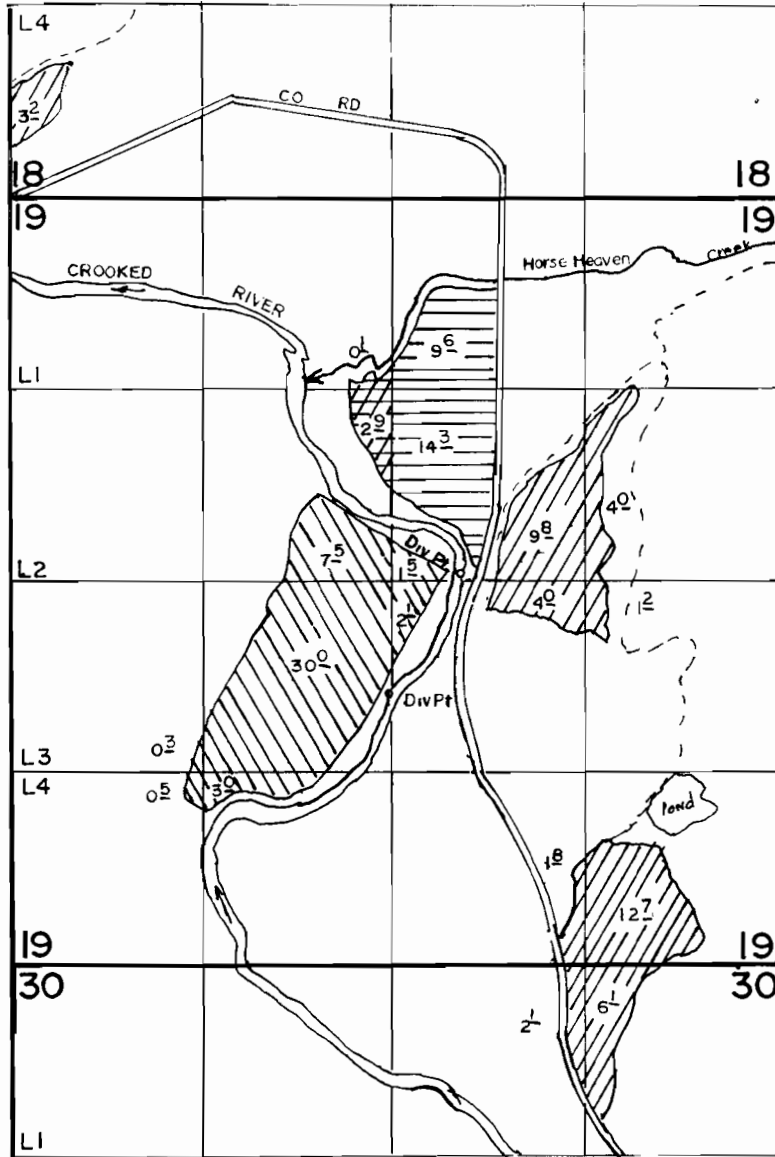

Div Pts Loc 1850' N & 2700' W - 2700' N & 2200' W Both From The SE Cor Of Section 19

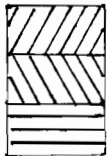

TRANSFER NO 3344

PRIMARY
CROOKED RIVER
SUPPLEMENTAL
CROOKED RIVER

SCALE: 1" = 1320'

FINAL PROOF SURVEY UNDER

TRANSFER No. 3344

Application No. 52797.. Permit No. 42025.....
IN NAME OF

.....BONNIEVIEW RANCH INC.....

Surveyed JAN..10.. 19.90., by B.W.BISHOP.....