


T. 39 S., R. 8 W., W. M.

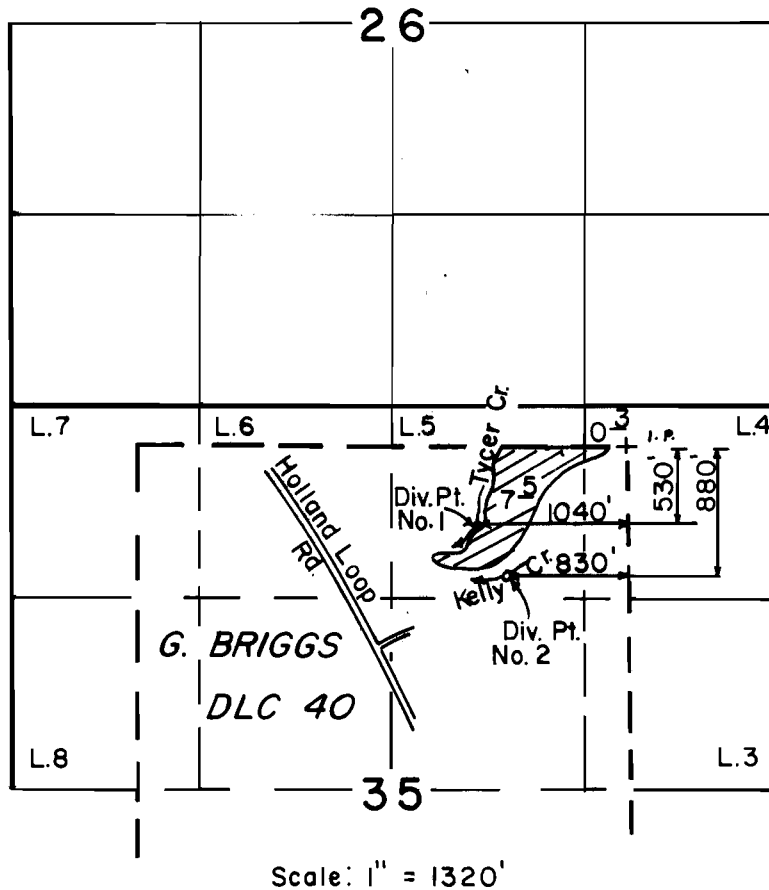

**FINAL PROOF SURVEY**  
**UNDER**

Application No. 55828. Permit No. 41888.....  
**IN NAME OF**

.....**WILLIAM RORISON**.....

Surveyed OCT. 31.. 1990, by B. S. JAMES...