


T. 39 S., R. 8 W., W. M.

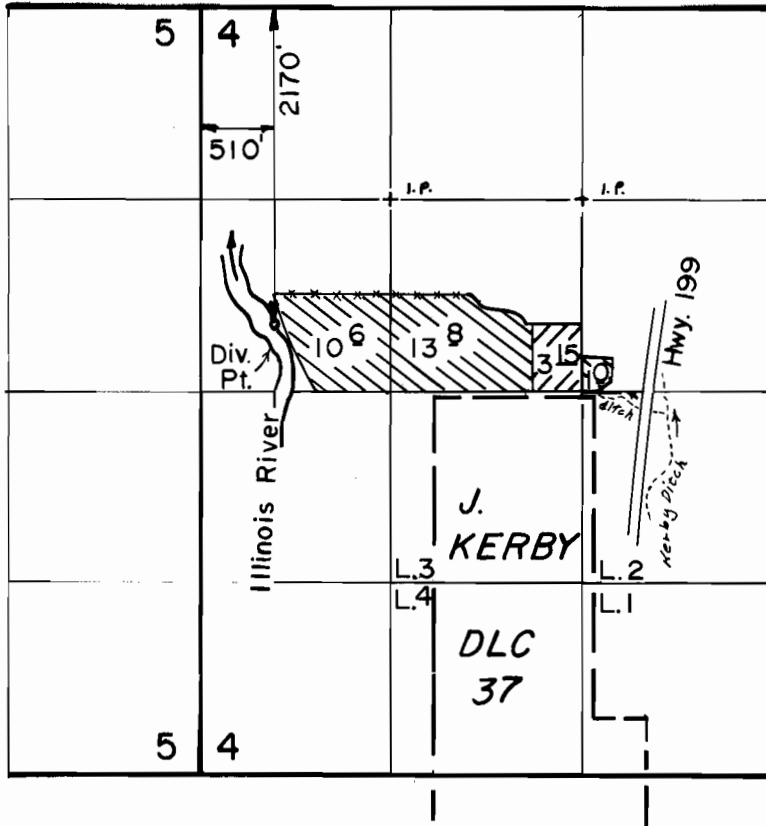

Scale: 1" = 1320'

T. 5168



P. 47292



**FINAL PROOF SURVEY**  
UNDER

TRANSFER NO. 5168

Application No. 64562 Permit No. 47292...

IN NAME OF

WILLIAM A. RORISON

Surveyed Sep. 10, 1987, by B. S. JAMES