T. 13S., R. 28E., W. M.

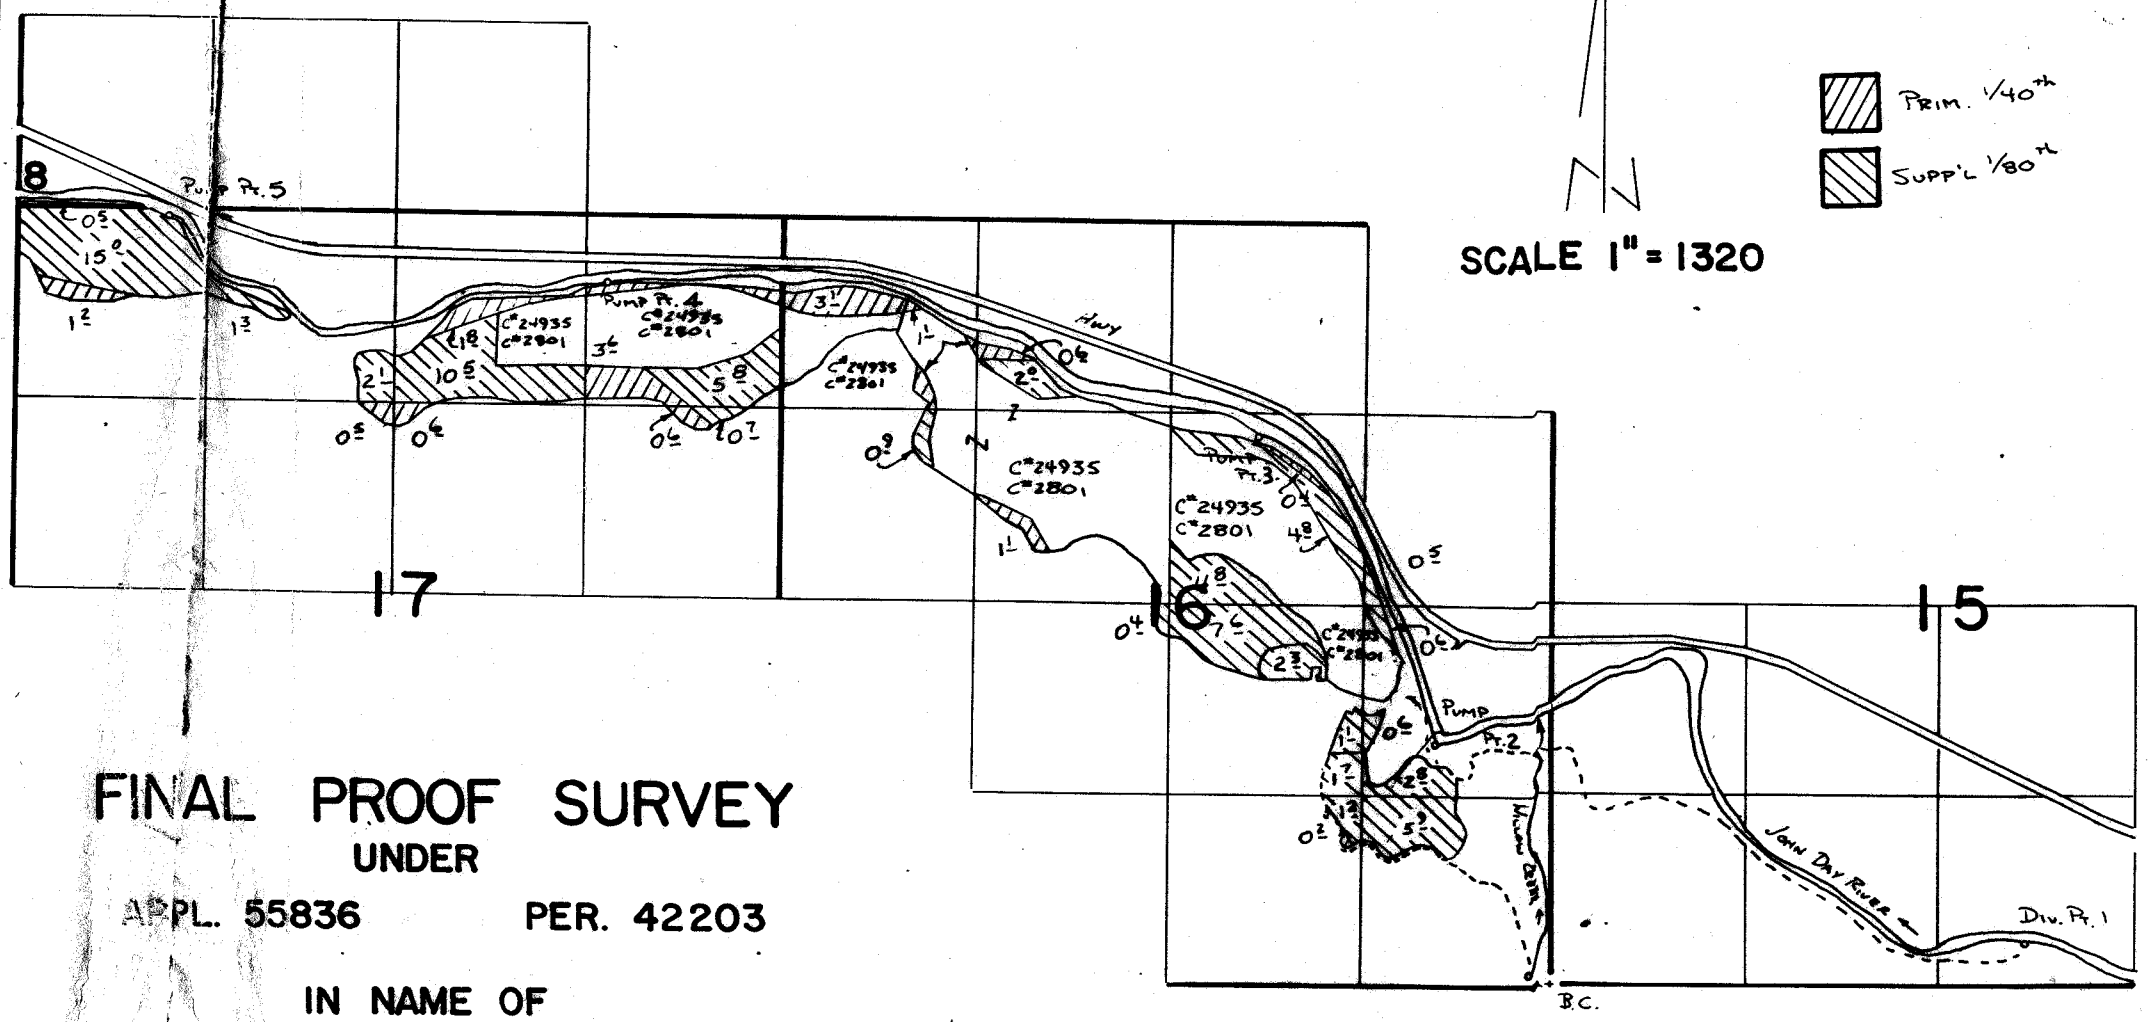

FINAL PROOF SURVEY

UNDER

APPL. 55836 PER. 42203

IN NAME OF

EDWARD HINES LUMBER COMPANY

Surveyed 3-21-1986, by V.L.CHURCH

Div. Pt. 1 Loc: 300'N. & 3220'E.
Pump Pt. 2 Loc: 1680'N. & 810'W.
Pump Pt. 3 Loc: 3800'N. & 2050'W.
} From SE Cor. Sec. 16

Pump Pt. 4 Loc: 460'S. & 4100'E.
Pump Pt. 5 Loc: 50'S. & 1040'E.
} From NW Cor. Sec. 17

41021-179-154R, 153C

2-3-89 VLC