
90684

T. 9S., R. 10W., W.M.

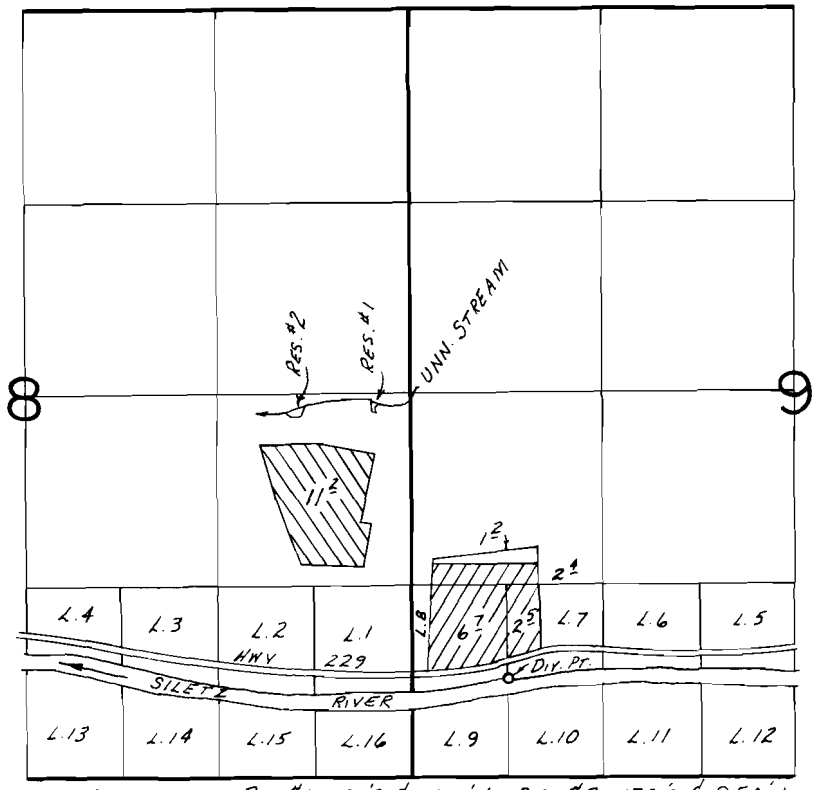



DIV. PTS. LOC.: RES. #1 - 50'S & 270'W., RES. #2 - 130'S & 850'W., RIVER - 1980'S & 660'E, ALL FROM E. 1/4 COR. SEC. 8

SCALE: 1" = 1320'

Tr. 3139

Permit 43915

FINAL PROOF SURVEY

UNDER

Transfer No. 3139

R-58163 R-7793

Application No. 58164 **Permit No.** 43915

IN NAME OF

WILFRED R. GERTTULA

Surveyed Sept. 11 **19**84, **by** B.W. BISHOP

PTS 1984-L