


T. 41 S., R. 9 W., W. M.

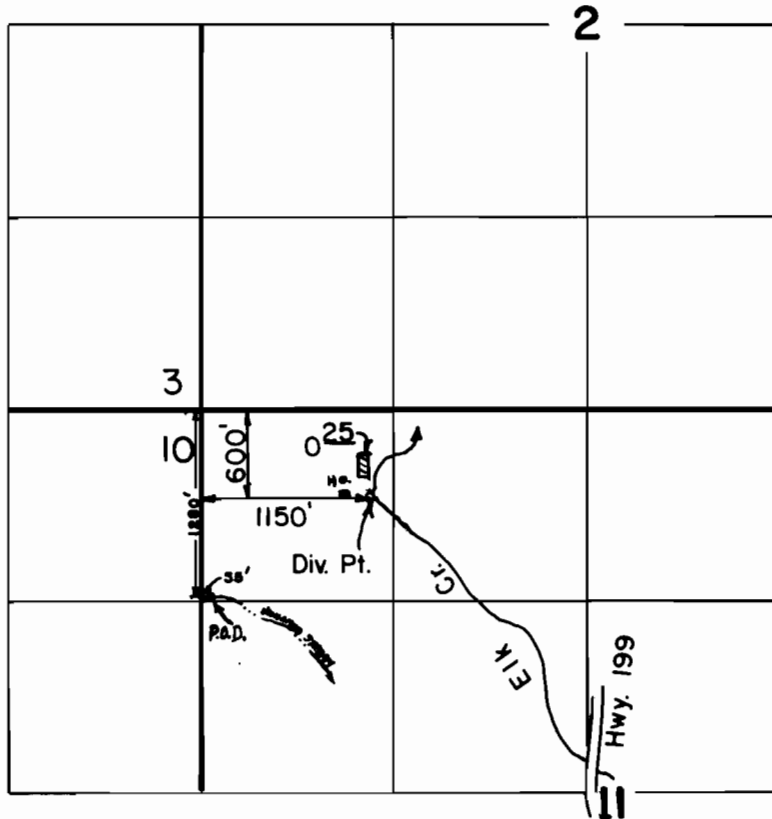

Scale: 1" = 1320'

FINAL PROOF SURVEY UNDER

Application No. 58561. Permit No. 44168...
IN NAME OF

.....ROBERT T. COUICK.....

Surveyed A.P.R. 12 1988., by B.S. JAMES....