


T. 9 S., R. 1 W., W. M.

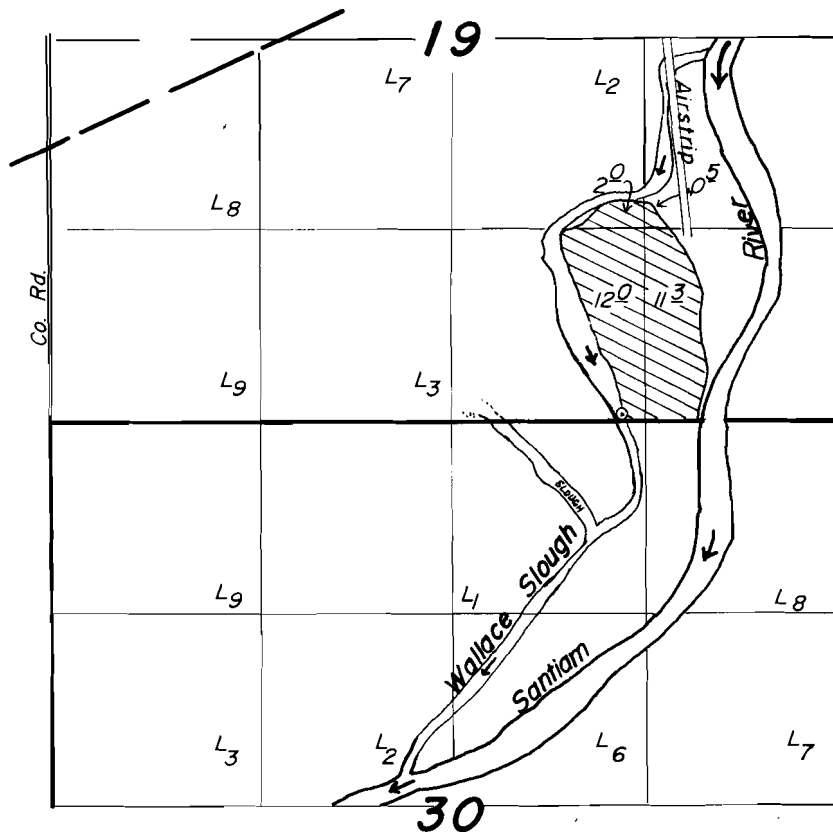

Div. Pt. Loc.: 40' N. & 1160' E. from S. 1/4 Cor. Sec. 19.

1" = 1320'
FINAL PROOF SURVEY
 UNDER

Application No. 59906... Permit No. 45426.....
 IN NAME OF

.....**GLIDEWELL FARMS, INC.**.....

Surveyed NOV...8... 1984, by T. WARREN.....

① 1/4 Sec 19
 3/16/84
 12 ac needs ΔPOD
 ③ Non-likely
 requires
 cause action and
 new app
 JWP
 5-2-87