


RECEIVED

T. 7 S. R. 4 W. W. M.

JUL 16 1992

WATER RESOURCES DEPT.
SALEM, OREGON

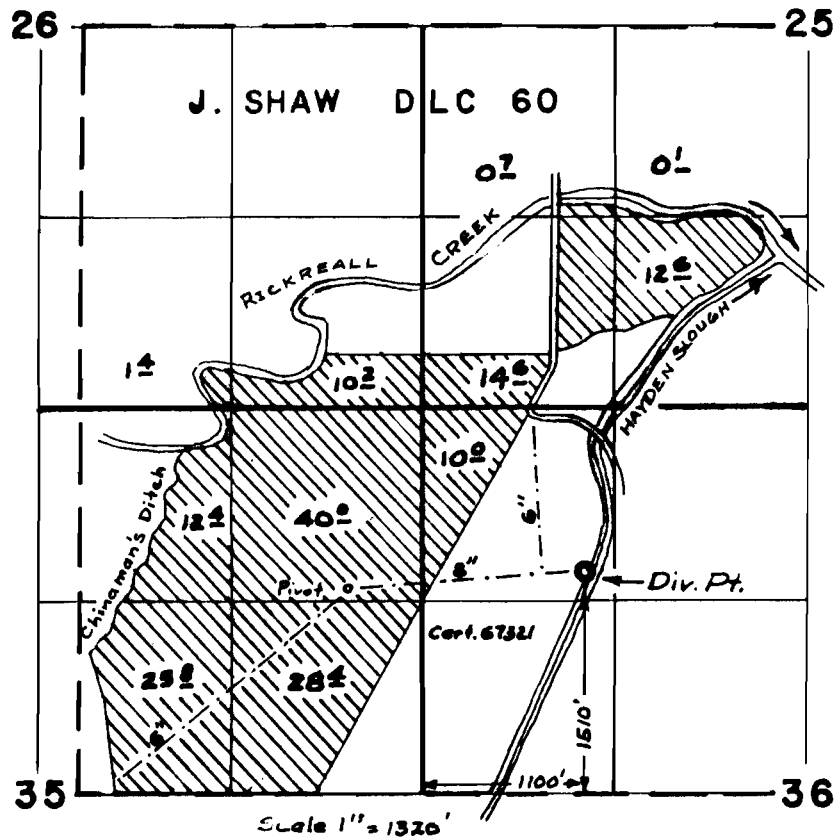

CLAIM OF BENEFICIAL USE
Applic. No. 61748 Permit No. 46052

GREEN VILLA FARMS

THE PREPARATION OF THIS MAP IS FOR THE PURPOSE OF IDENTIFYING THE LOCATION OF THE WATER RIGHT ONLY AND HAS NO INTENT TO PROVIDE DIMENSIONS OR LOCATION OF PROPERTY OWNERSHIP LINES.

