


T. 39 S., R. 8 W., W. M.

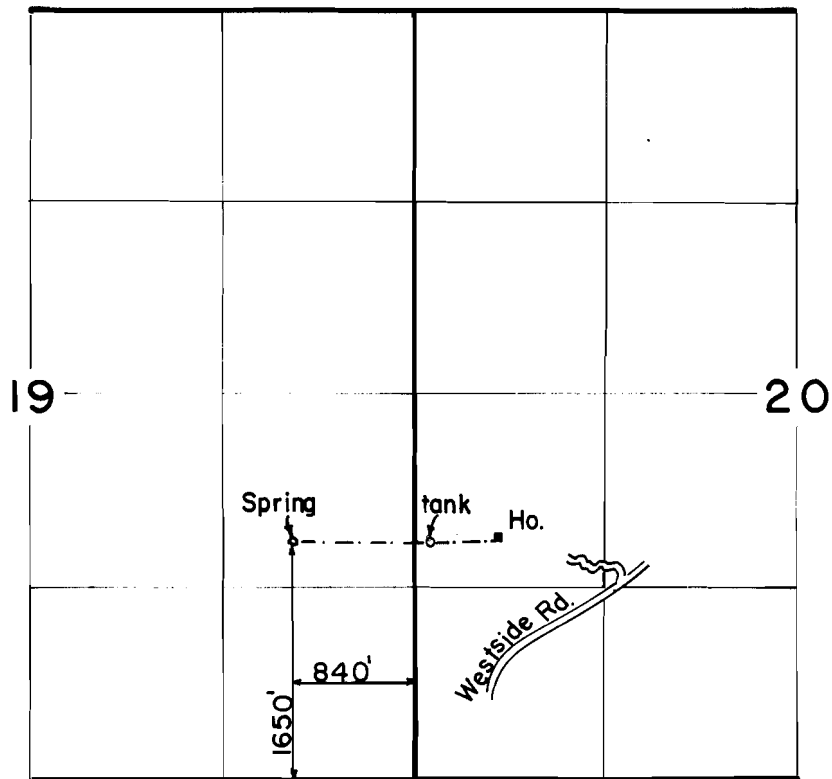

Scale: 1" = 1320'

FINAL PROOF SURVEY
UNDER

Application No. 62981. Permit No. 46974....
IN NAME OF

.....MACIEJ LESIECKI.....

Surveyed JULY 18, 1990, by B. S. JAMES.