


Application No. 67747

Permit No. 51004

# SUN PASS UNIT


67924

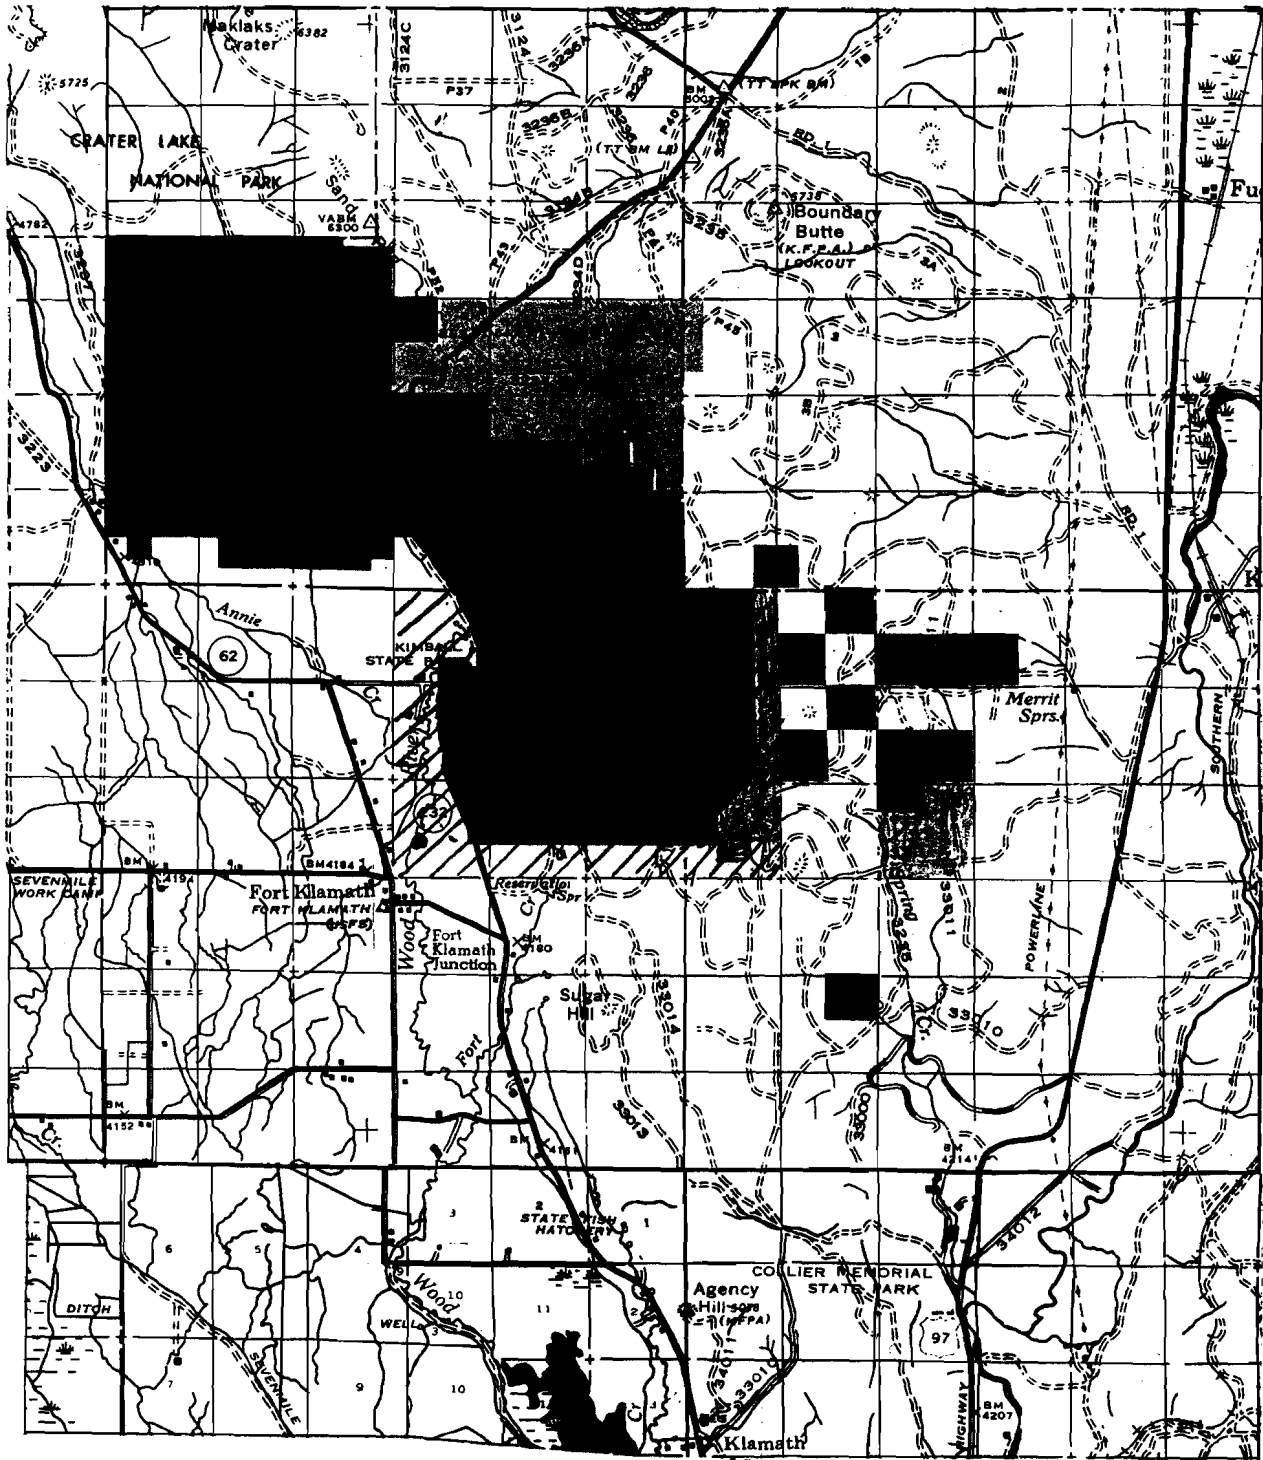

R. 7 1/2 E.

R. 7 E.

1-72

 = LAND THAT WATER  
 TO BE USED ON FOR  
 ROAD DUST ABATEMENT

Yellow - State Land Board


Green - State Forestry Lands

● = POINT OF DIVERSION

51004  
23

Application No. 67747  
Permit No. 51004

RECEIVED  
OCT 13 1983  
WATER RESOURCES DEPT.  
SALEM, OREGON

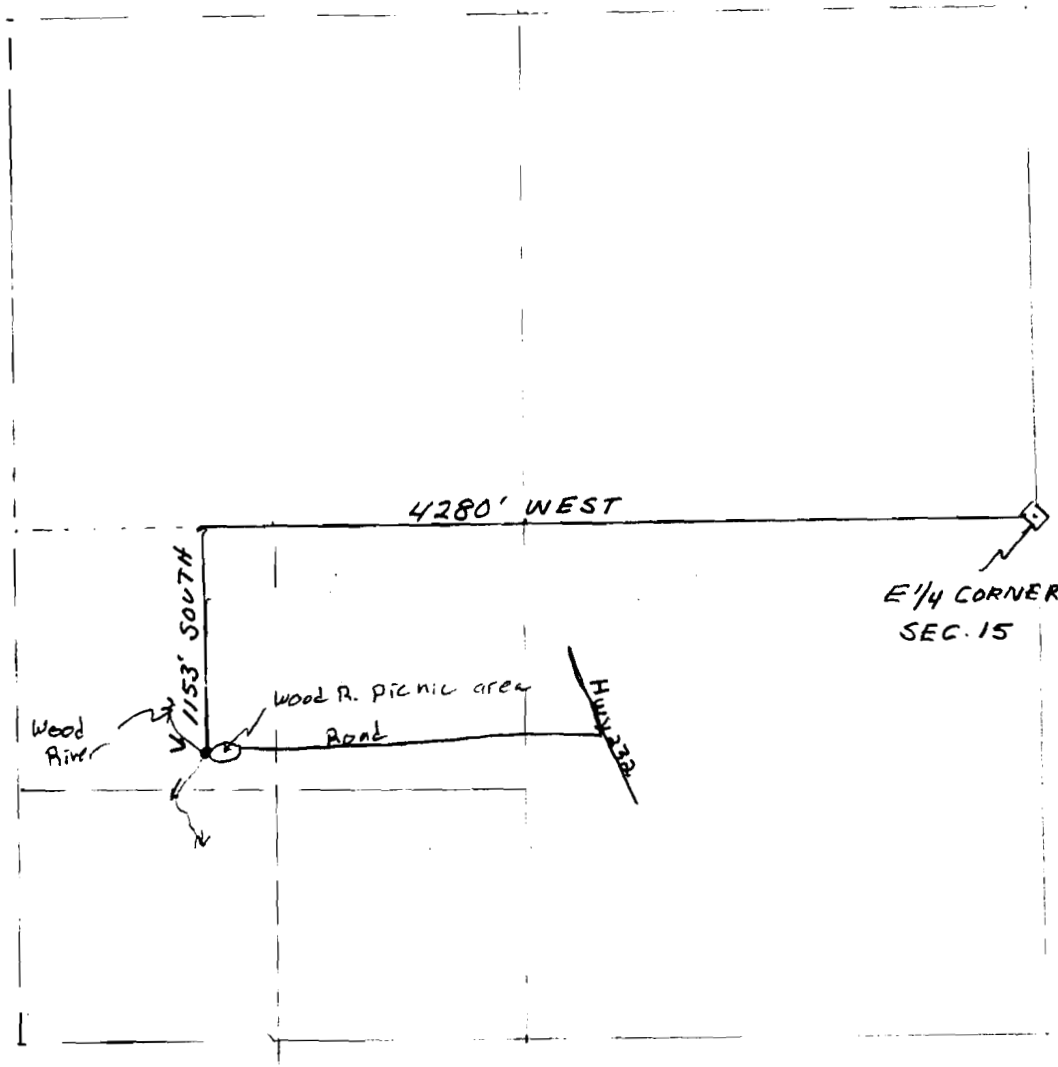

SECTION 15  
T33S R7 1/2 E  
SCALE 1" = 1000'