


Application No. 67757
 SUN PASS UNDER Permit No. 51006


67926

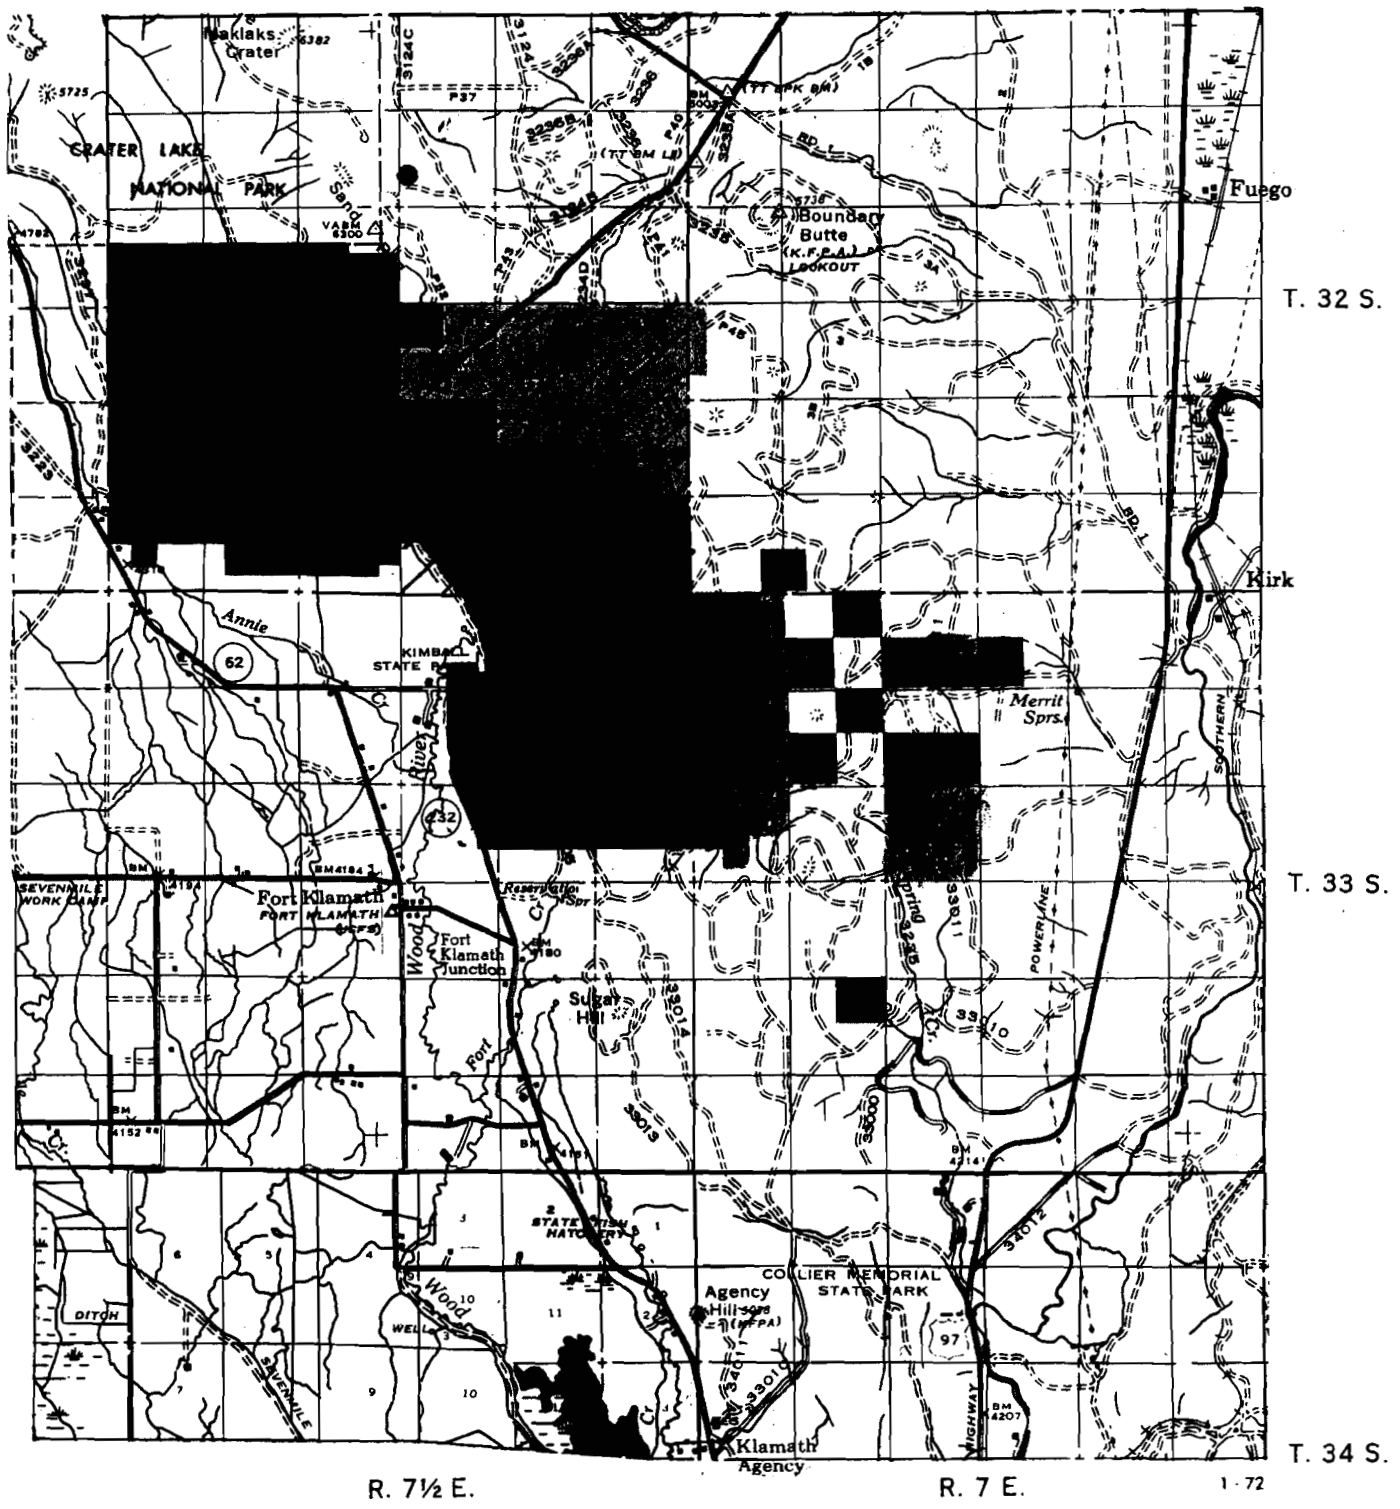

////// = LAND THAT WATER TO BE USED ON FOR ROAD DUST ABATEMENT
 Yellow - State Land Board
 Green - State Forestry Lands

Application No. 67757
Permit No. 51006

SECTION CORNER
20, 21, 28 & 29
T. 31 S. R. 7 E. W. M.

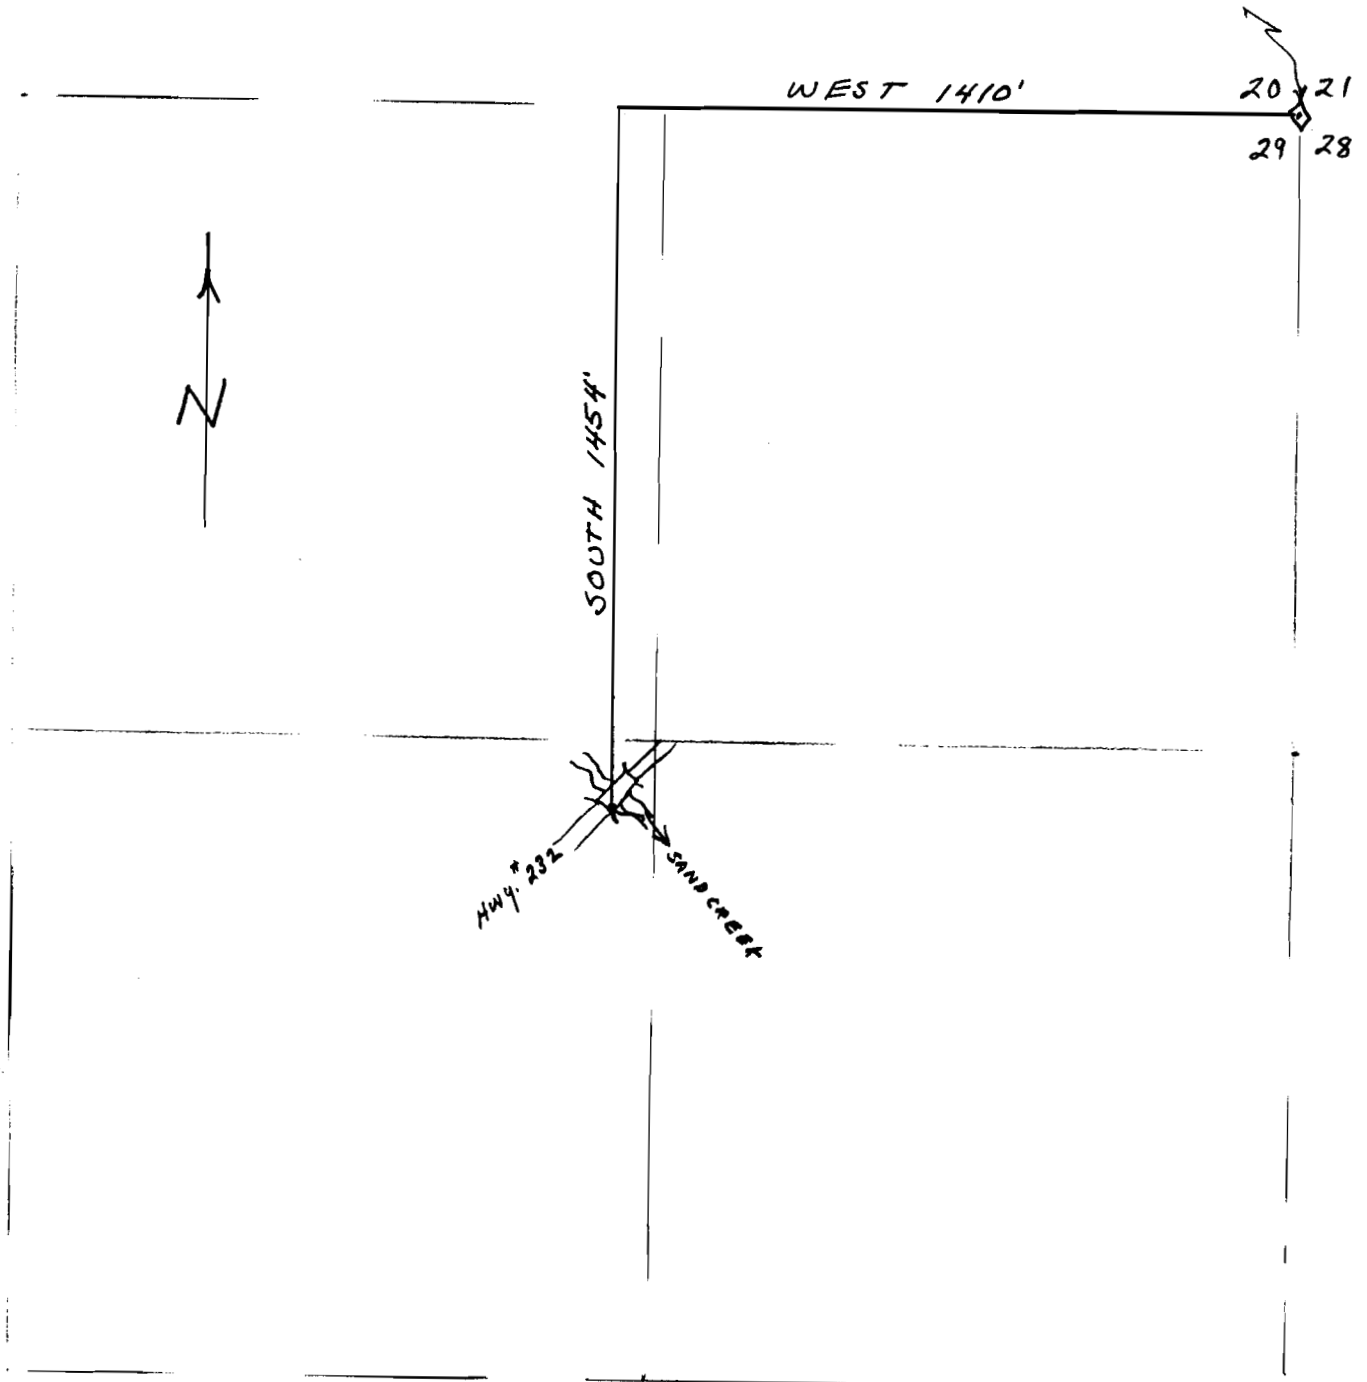

NE 1/4 SECTION 29
T. 31 S. R. 7 E. W. M.
SCALE 1" = 400'

RECEIVED
OCT 13 1983
WATER RESOURCES DEPT.
SALEM, OREGON