


T. 27S., R. 5W., W. M.

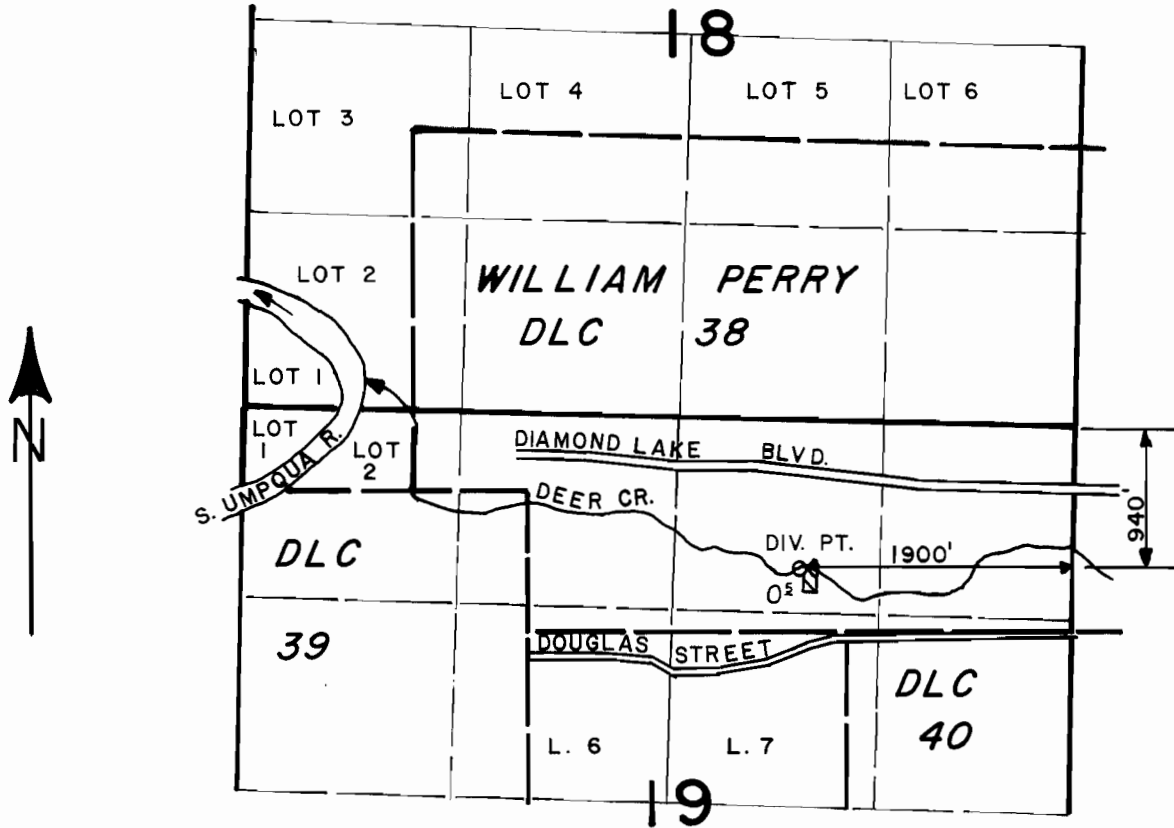

SCALE: 4" = 1 MILE

FINAL PROOF SURVEY
UNDER

Application No. 68396... Permit No. 49394.....
IN NAME OF

JAMES A. AND COLLEEN COOPER

Surveyed OCT. 23. 1987., by J. M. SCHMORDE