


Arthur A. Selander
Mar. 21, 1926

TPS. 27 & 28 S. R. 13 W. WILL. MER.
COOS COUNTY, OREGON.

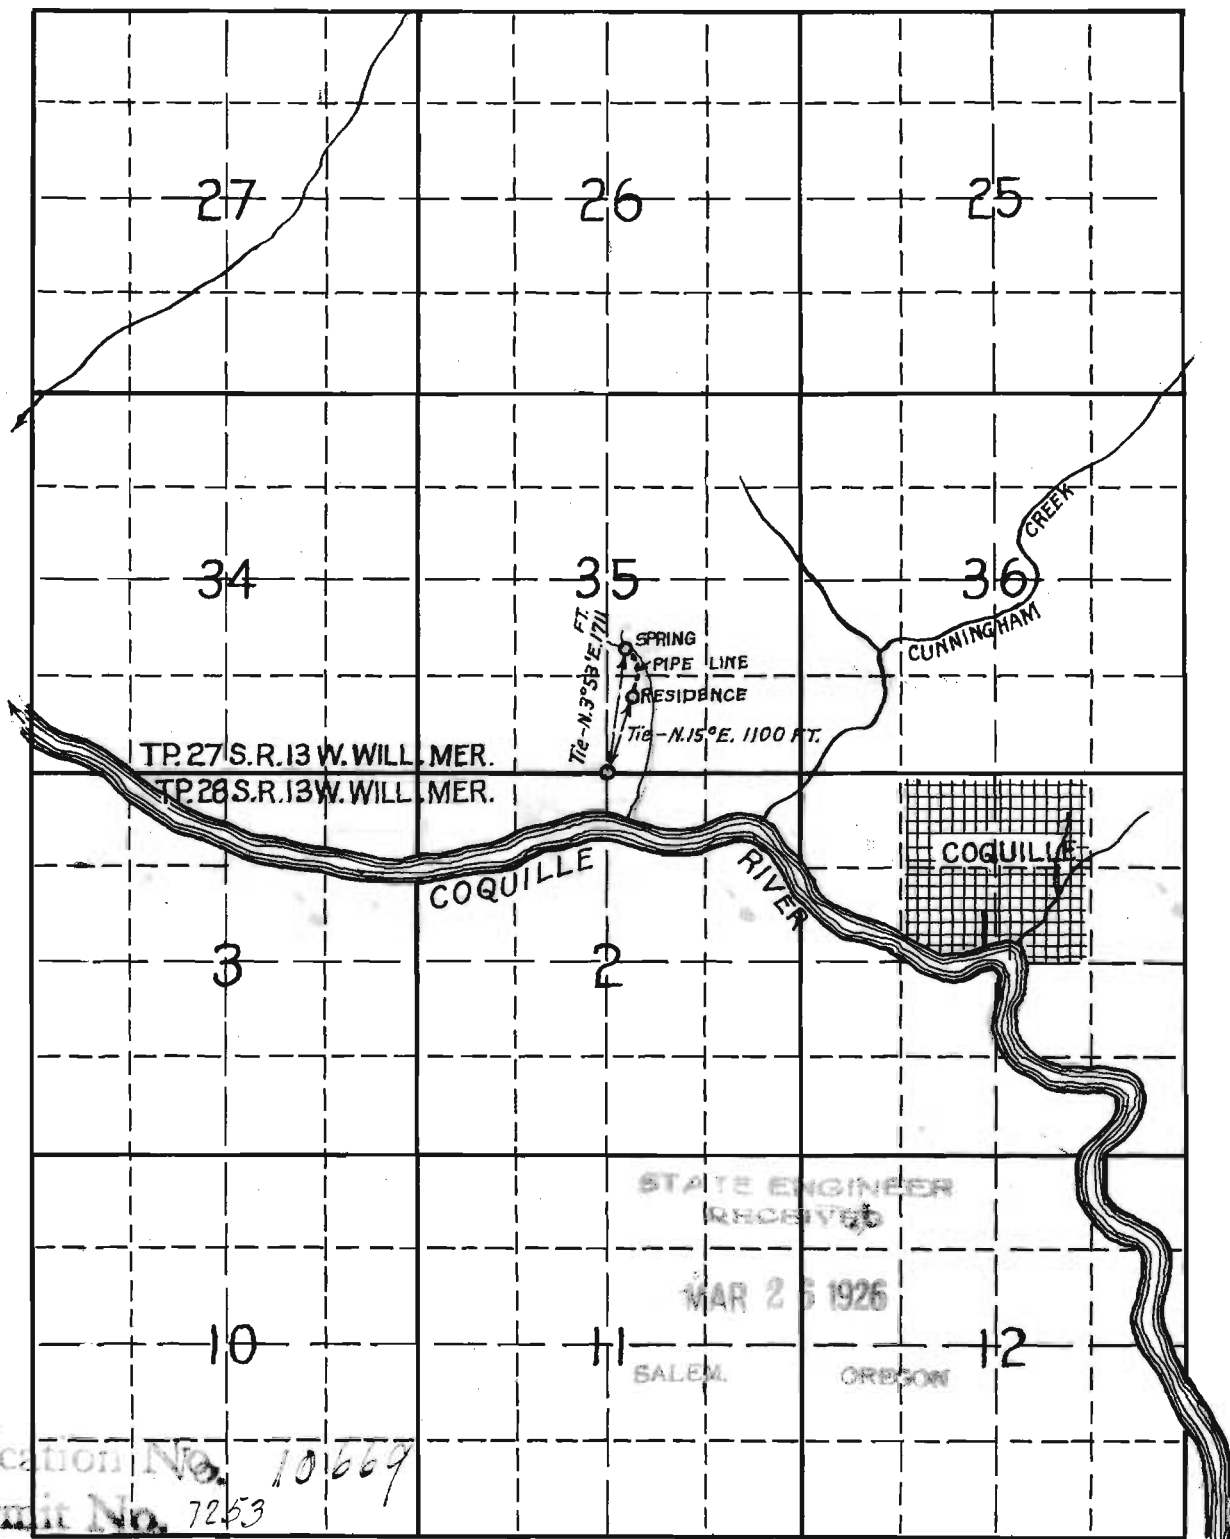

Scale: 2 in. = 1 mile

MAP -
To accompany application for permit

% RHEA LUPER
State Engineer

Applicant -
John A. Martin, Coquille, Ore.

I, Arthur A. Selander, of Coquille, Oregon, do hereby certify that this map was made from notes taken during an actual survey made by me on March 21, 1926, and that it correctly represents the works described in the accompanying application, together with the location of streams and other ditches in the immediate vicinity.

Arthur A. Selander
Registered Professional Engineer

Oregon No. 655

Date of Reg. Jan. 1st, 1920.

PERMIT NO.