


T.8S.,R.46E.,W.M.

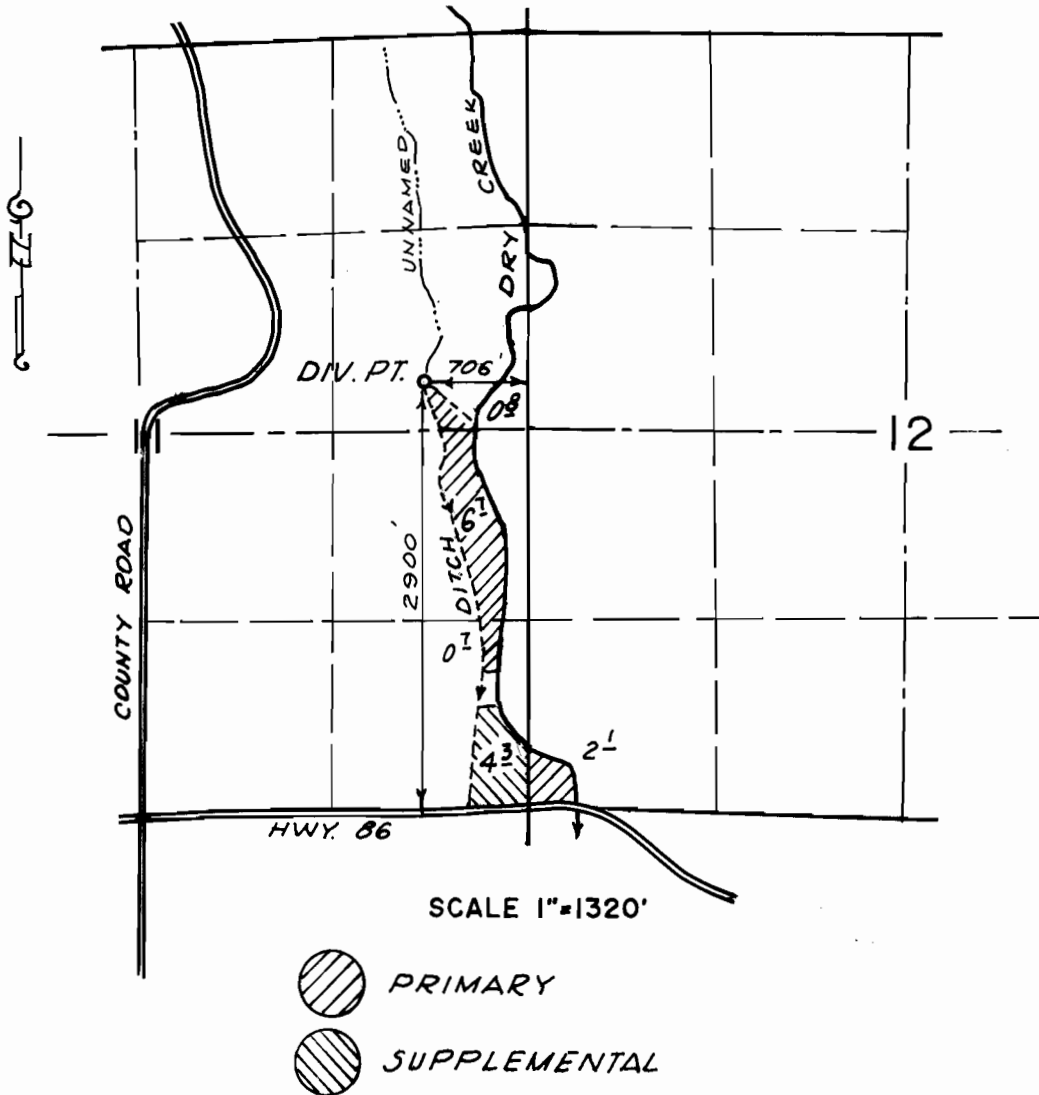

THE PURPOSE OF THIS MAP IS FOR IDENTIFYING THE LOCATION OF THE WATER RIGHT ONLY AND IS NOT INTENDED TO PROVIDE LEGAL DIMENSIONS OF PROPERTY OWNERSHIP LINES.

## FINAL PROOF SURVEY UNDER

Application No. 69391..... Permit No. 50923.....

IN NAME OF

GORDON W. & DEBORAH S. SUMMERS

Surveyed NOVEMBER 30,..... 1990

