


T.34S.,R.2E.,W.M.

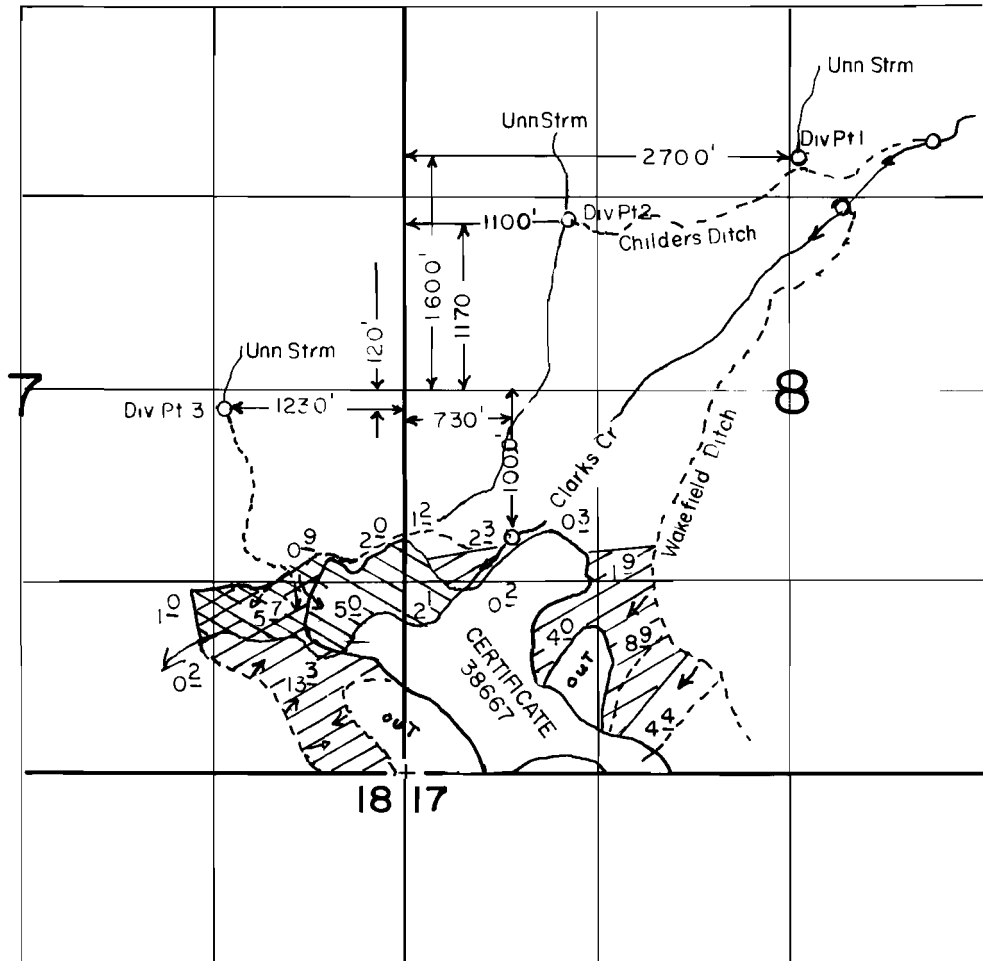

SCALE: 1" = 1320'

FINAL PROOF SURVEY

UNDER

TRANSFER NO. 3291

3293


2635

Application No. Permit No.

IN NAME OF

LAWRIE D. & PHYLLIS RUTHERFORD

Surveyed JUNE 28, 1989, by B. S. JAMES

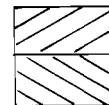

Transfer No 3291 Primary
2635

Transfer No 3293
Supplemental