


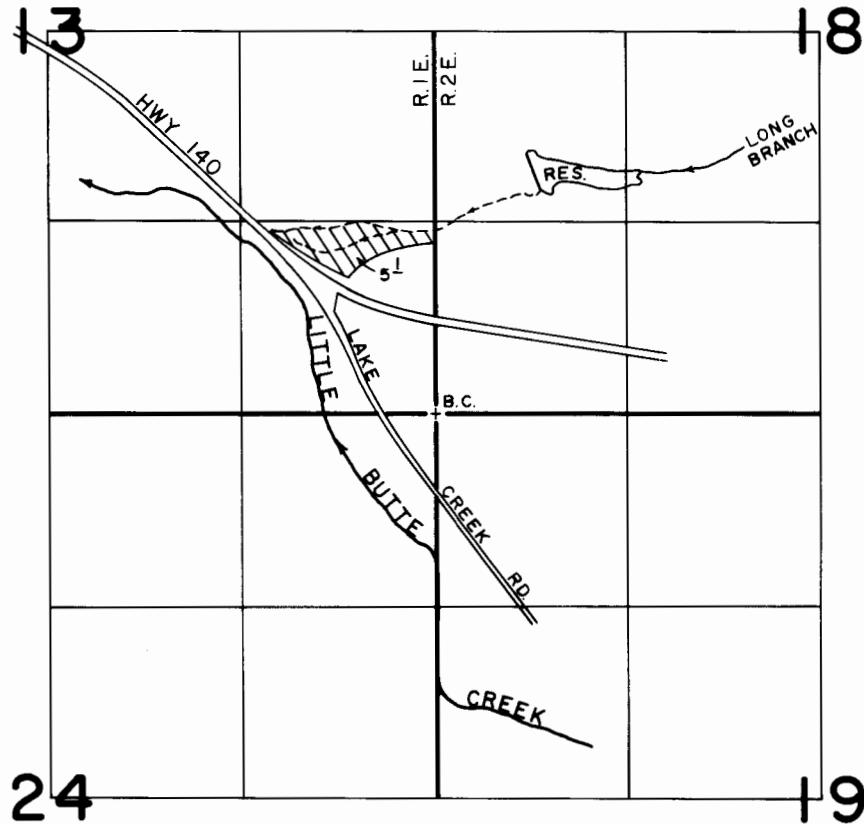

T. 36 S., R. 18 & 2 E., W.M.



SCALE: 1" = 1320'

FINAL PROOF SURVEY UNDER


TRANSFER NO. 3043

Application No. Permit No.
IN NAME OF

.....THEODORE BLOOMBERG.....

Surveyed JUNE 5, 1989, by B.S. JAMES.....

T.36 S.R.1&2 E.W.M.

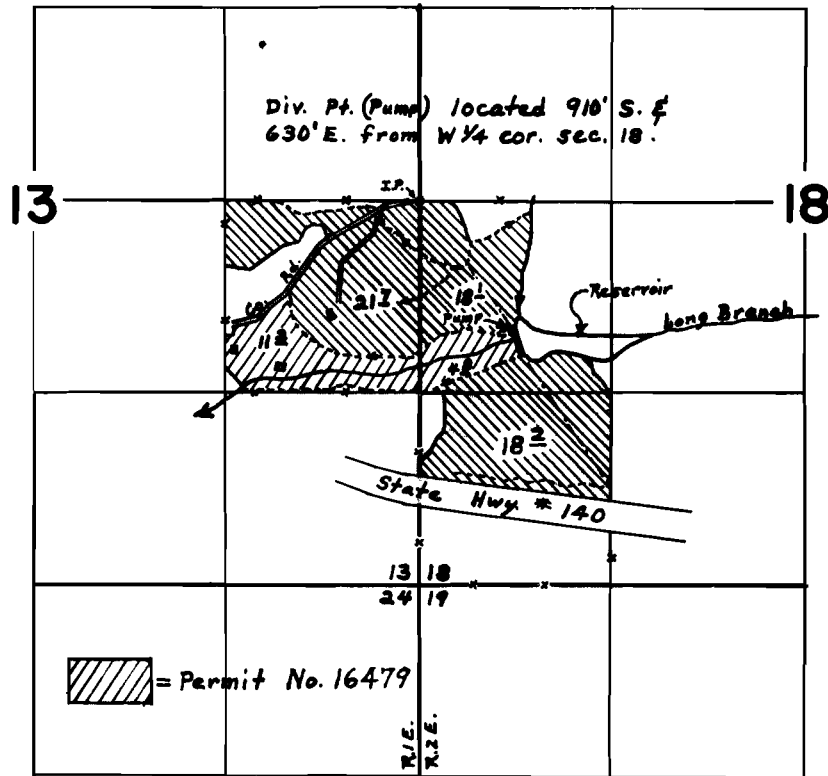

FINAL PROOF SURVEY UNDER

30444 23906
Application No. R-30443 Permit No. R-1803
IN NAME OF

THEODORE BLOOMBERG, et al.

Surveyed May 24, 1967, by W. J. Ruppert
June 21, 1967 by D. L. Hendrix