


T.10S., R.10W.W.M.

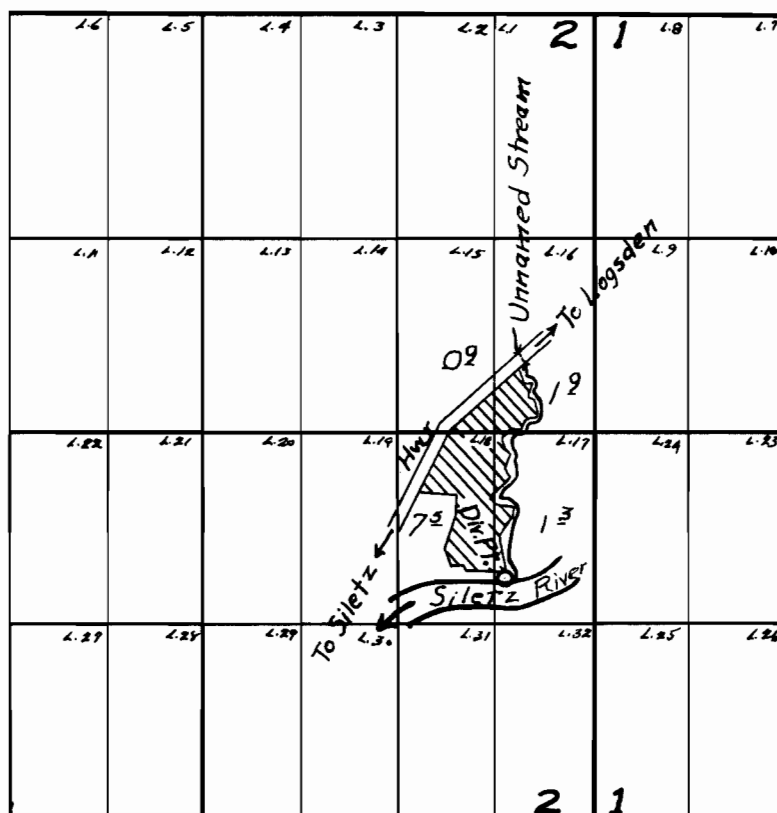

FINAL PROOF SURVEY

UNDER

Application No. 28093 Permit No. 22090
IN NAME OF

LESTER & EFFIE WALTMAN

Surveyed 21 April 1955, by H.L. Coffman