


37-1-1
10138

T. 37 S., R. 7 W., W. M.

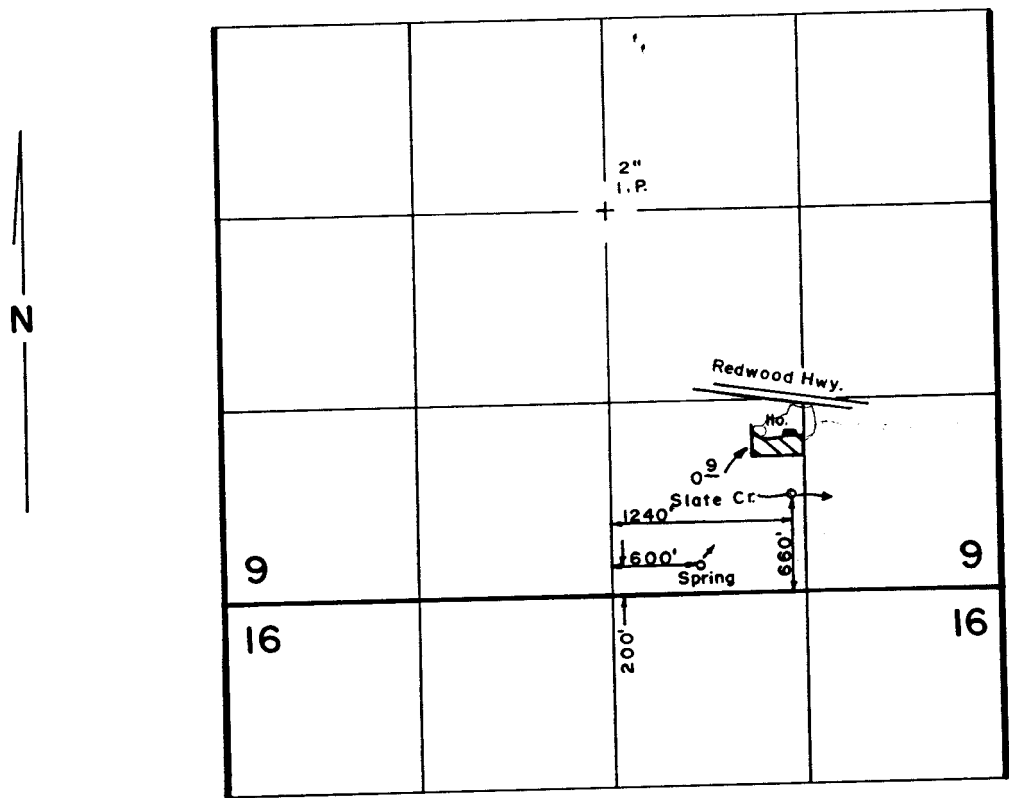

Scale: 1" = 1320'

FINAL PROOF SURVEY
UNDER
TRANSFERS NO. 5441 & 5457
Application No. Permit No.
IN NAME OF
.....RUSSELL J. HUDSON.....
Surveyed JUL. 28. 1986, by B. S. JAMES....